


T.38 S. R.5 W.W.M.

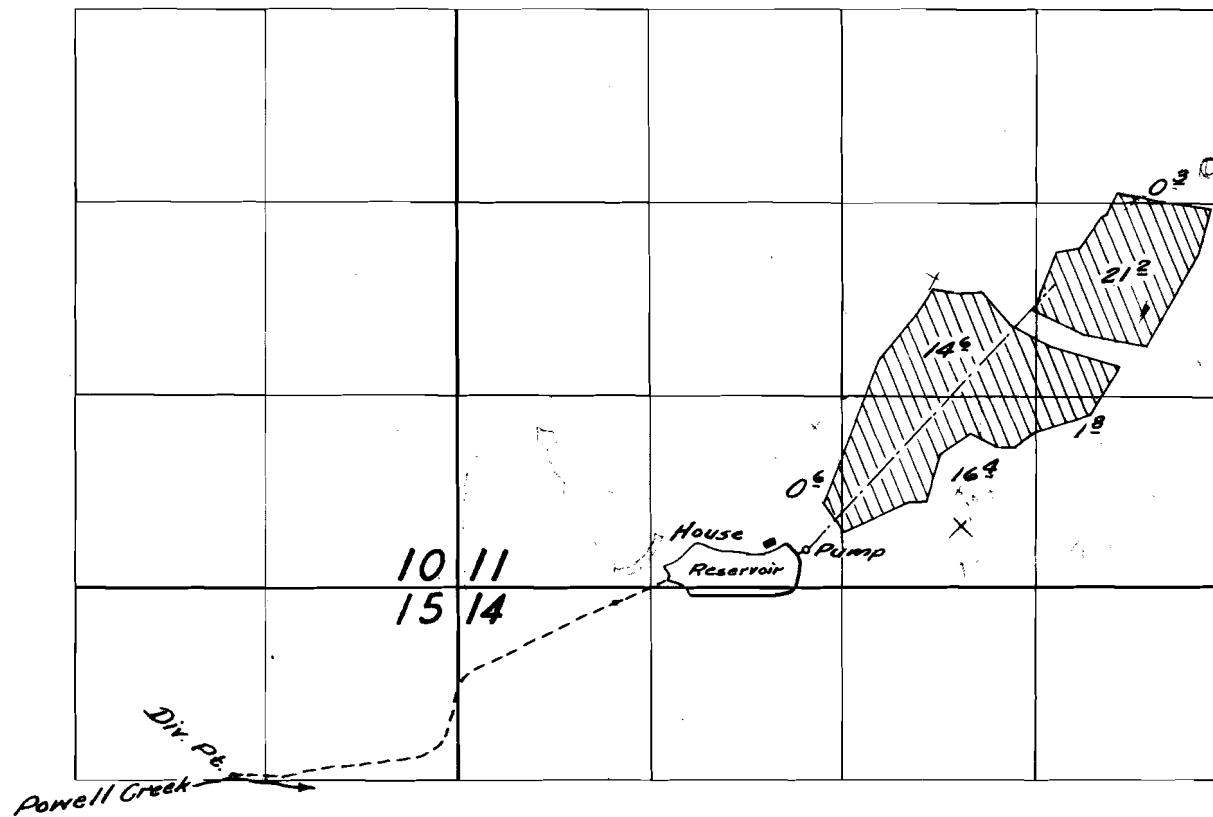

# FINAL PROOF SURVEY

UNDER

Application No. ~~R-30242~~ <sup>R-30242</sup> Permit No. ~~R-1845~~ <sup>R-1845</sup>

IN NAME OF

E. N. Lippert

Surveyed July 22, 1959, by C. B. Britton