


T.38 S. R.5 W.W.M.

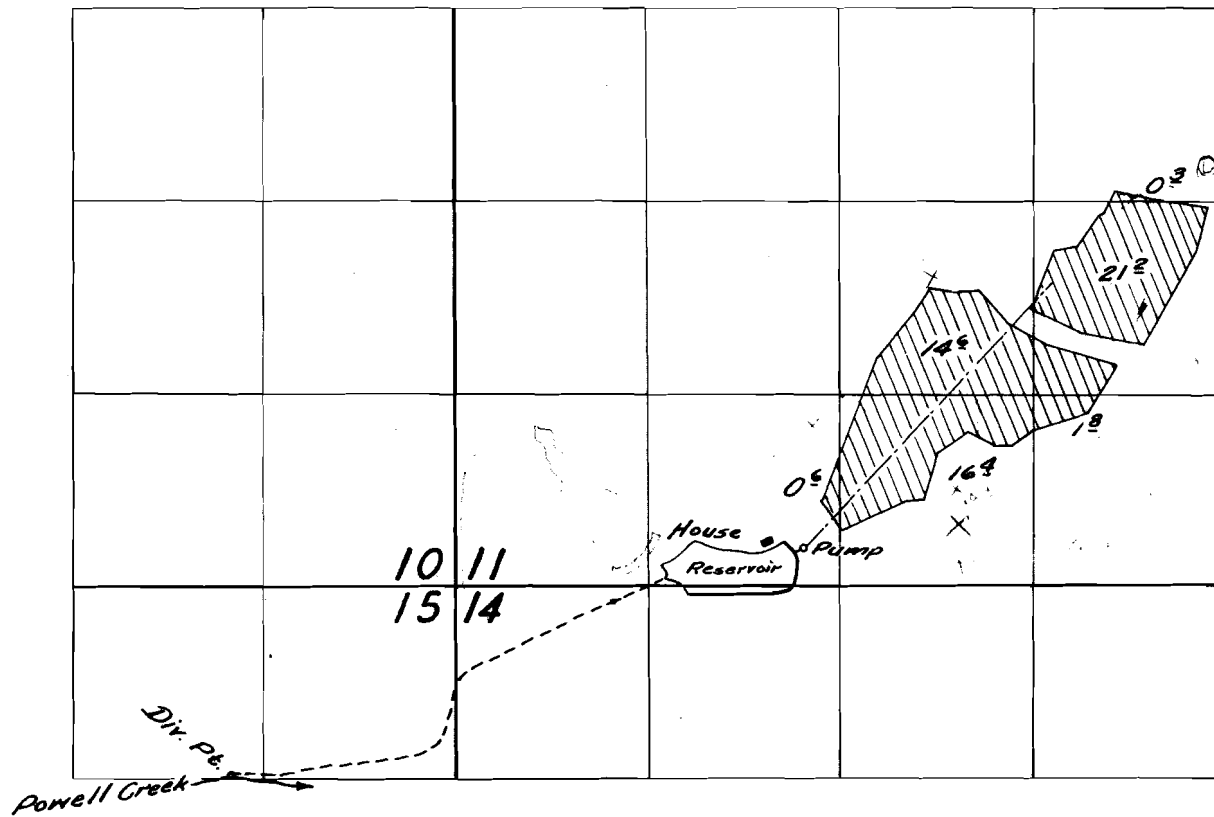

FINAL PROOF SURVEY

UNDER

Application No. ~~30242~~ ^{R-30242} Permit No. ~~24106~~ ^{R-1845}

IN NAME OF

E. N. Lippert

Surveyed July 22 19 59, by C. Bartlett