


T.4 S.R.14 E.W.M.

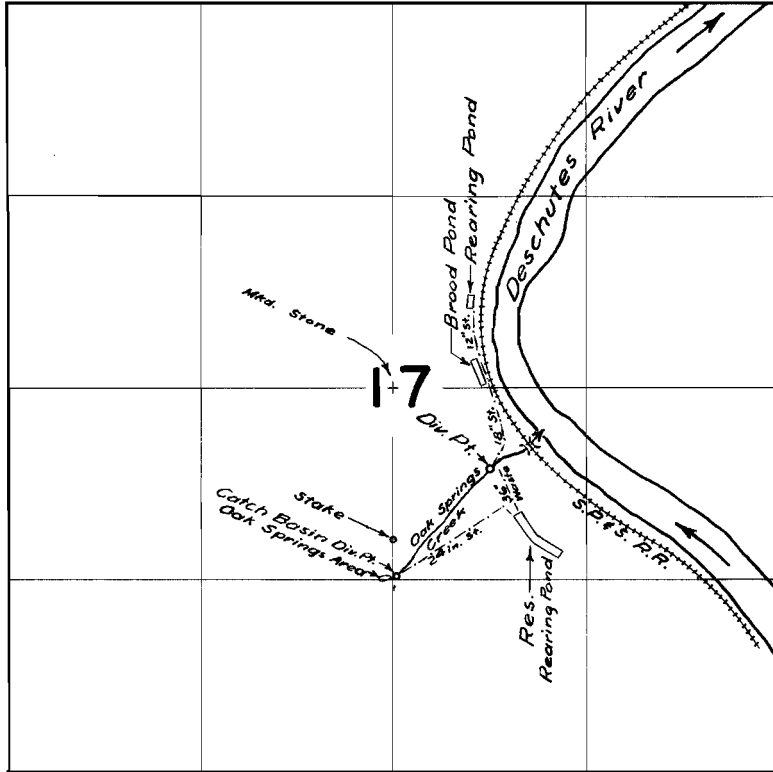

FINAL PROOF SURVEY UNDER

24138 19000
30863 24326
Application No. *R-30958* Permit No. *R-1894*
IN NAME OF

OREGON STATE GAME COMMISSION

Surveyed *13 Nov. 1959* by *M. Bish*