


# T.4 S.R.14 E.W.M.

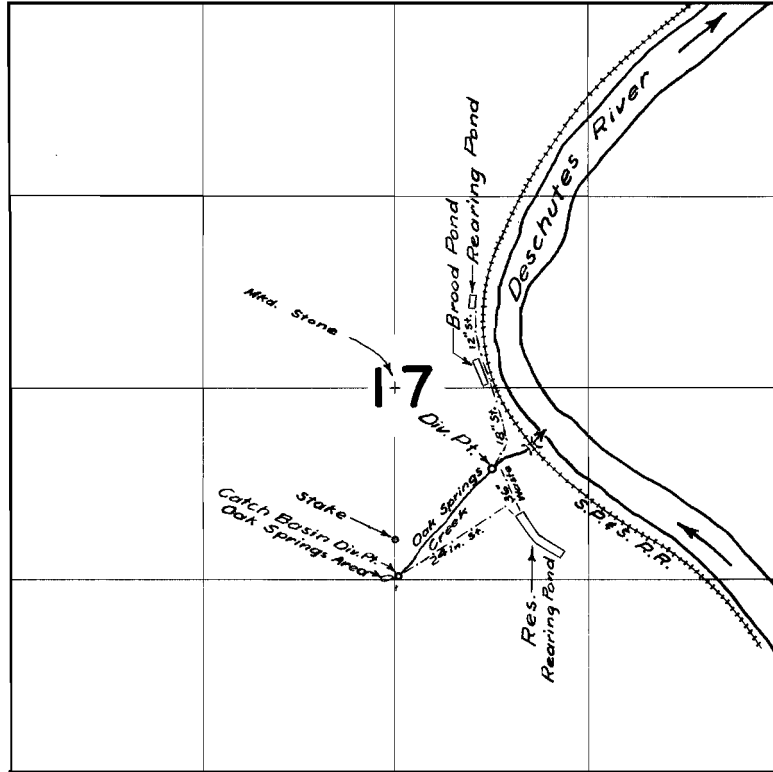

## FINAL PROOF SURVEY UNDER

24138                      19000  
30863                      24326  
Application No. *R-30958* Permit No. *R-1894*  
IN NAME OF

*OREGON STATE GAME COMMISSION*

Surveyed *13 Nov. 1959* by *M. Bish*