


SURVEYORS CERTIFICATE

I, W. E. Anderson of Tillamook, Ore. do hereby certify that this map was made from notes taken during an actual survey made by me in July 1956, and that it represents the works herein shown

W E Anderson

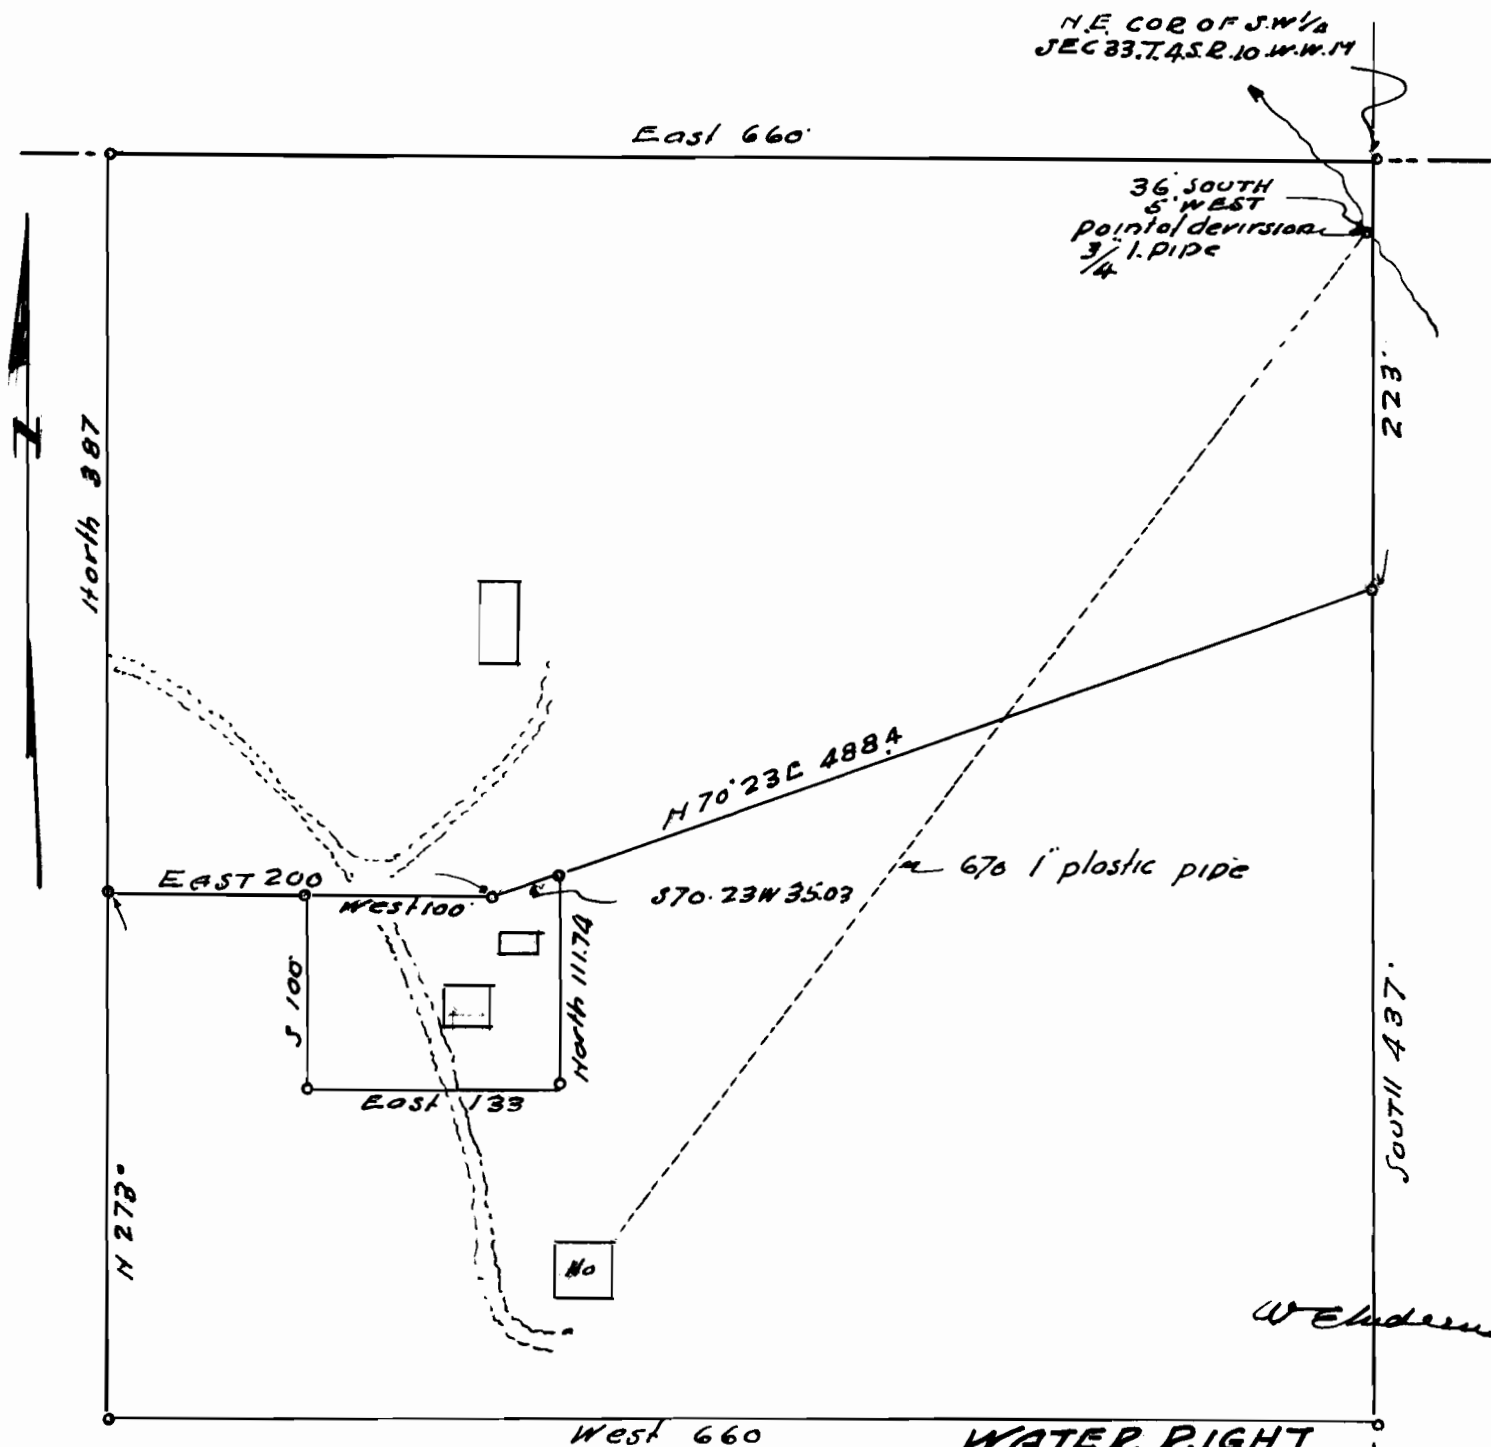

W E Anderson

Application No. 31114
Permit No. 24474

WATER RIGHT
JEFFERSON W. KREBS &
MAXINE E. ROLLINS
SEC 33, TWP 4S, R 10W, W 14
TILLAMOOK ORE
Scale 1" = 100'