


4204

Per # 2427
2748.

Township 14 S

Range 34 E. W. M.

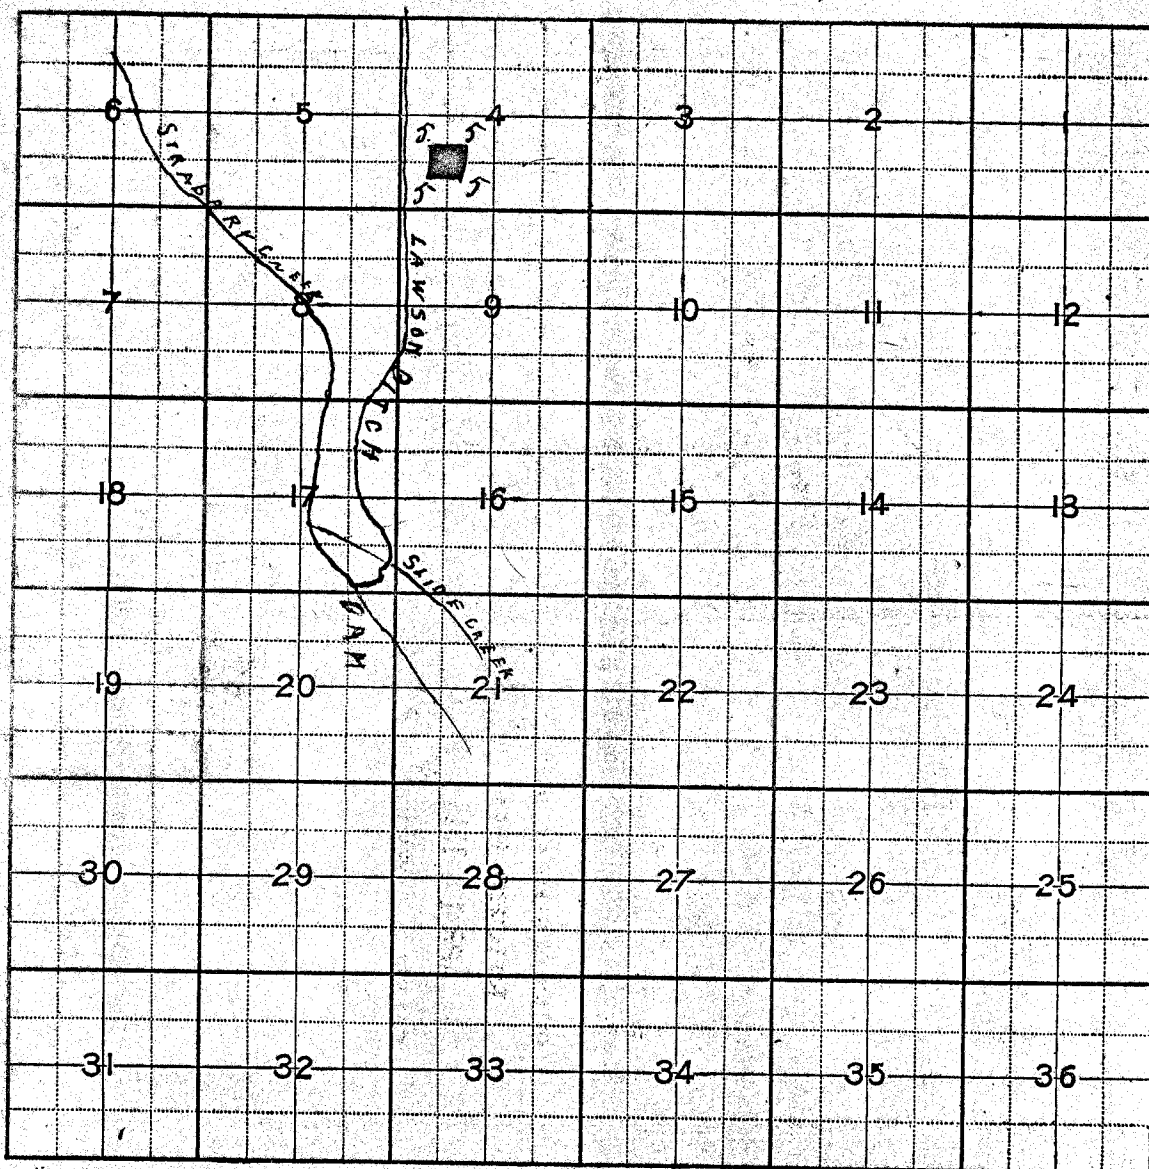

When sending in fire reports, please put as much information on plats as is possible with regard to new or old burns or dangerous fire traps caused by slashings, windfalls, or from whatever cause; also all trails, roads, or railroads, and location of sawmills, logging camps, settlers' cabins or other improvements.

OFFICE OF STATE ENGINEER
RECEIVED
APR 14 1915
SALEM, OREGON

Application No. 4204
Permit No. 2427