


T.3N. R. 10W. W.M.

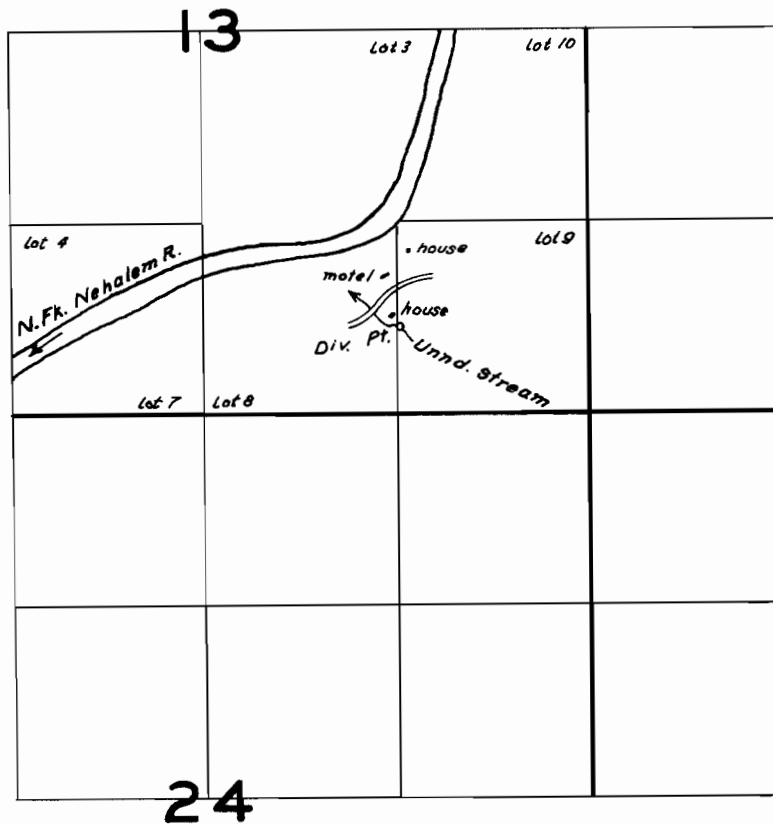

FINAL PROOF SURVEY
UNDER

Application No. 31253 Permit No. 24624
IN NAME OF

Pearl & Lou Belle Ludtke

Surveyed April 15, 1959, by R.H. Jackson