


T.17S. R.2W.W.M.

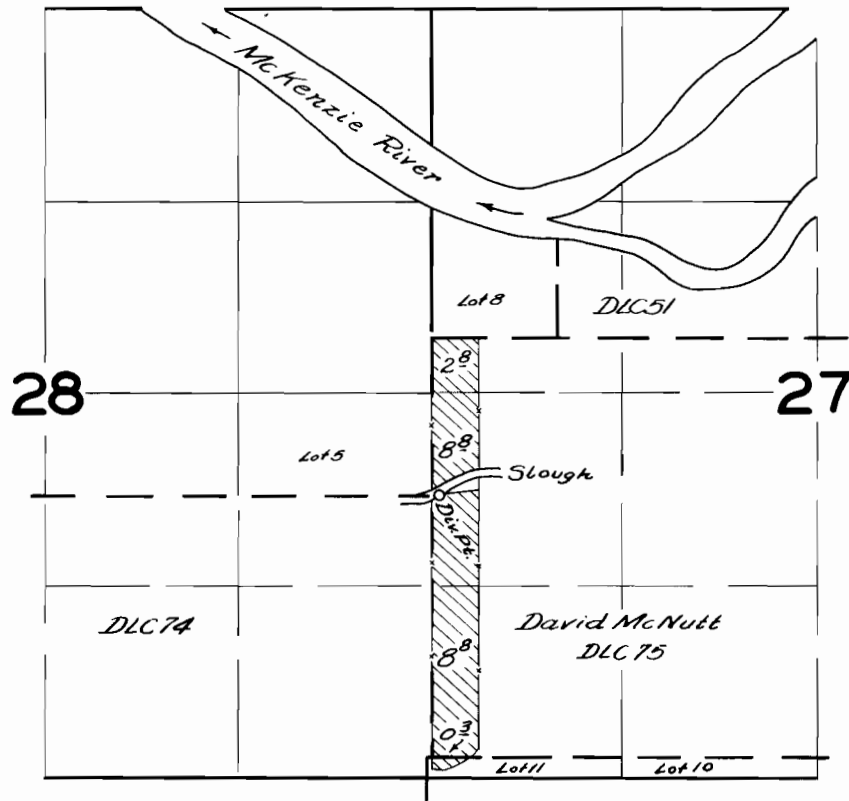

**FINAL PROOF SURVEY**  
UNDER

Application No. 31418 Permit No. 24794  
IN NAME OF

*Vance E. & Ruby E. Strunk*

Surveyed April 8, 1959, by *C.O. Burt*