


T.22 S.R.46 E.W.M.

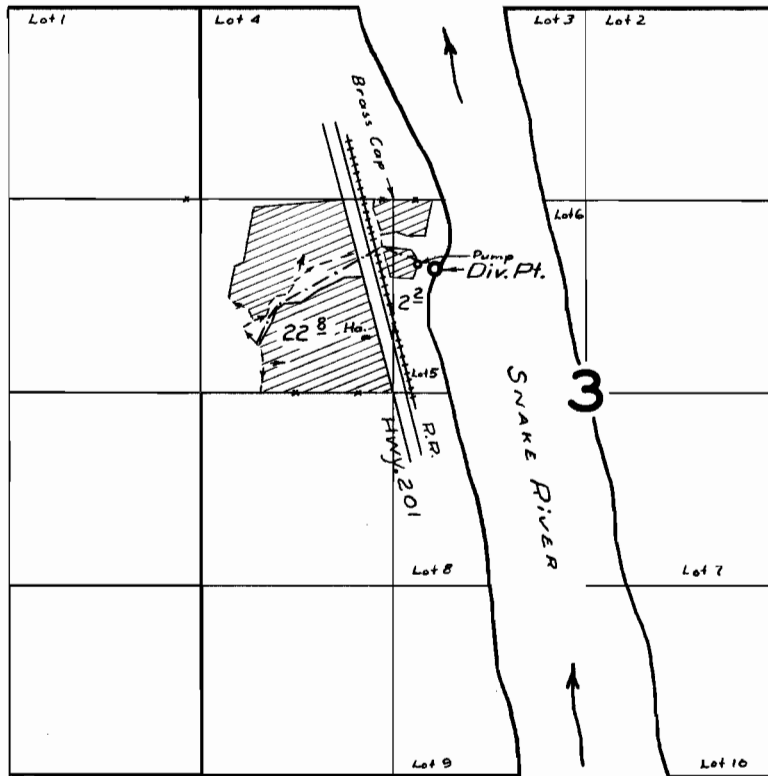

FINAL PROOF SURVEY UNDER

Application No. 31819 Permit No. 25147
IN NAME OF

E.E. EASTMAN

Surveyed Sept. 17 1959, by Tom G. Rich