


T.28S.R.45E.W.M.

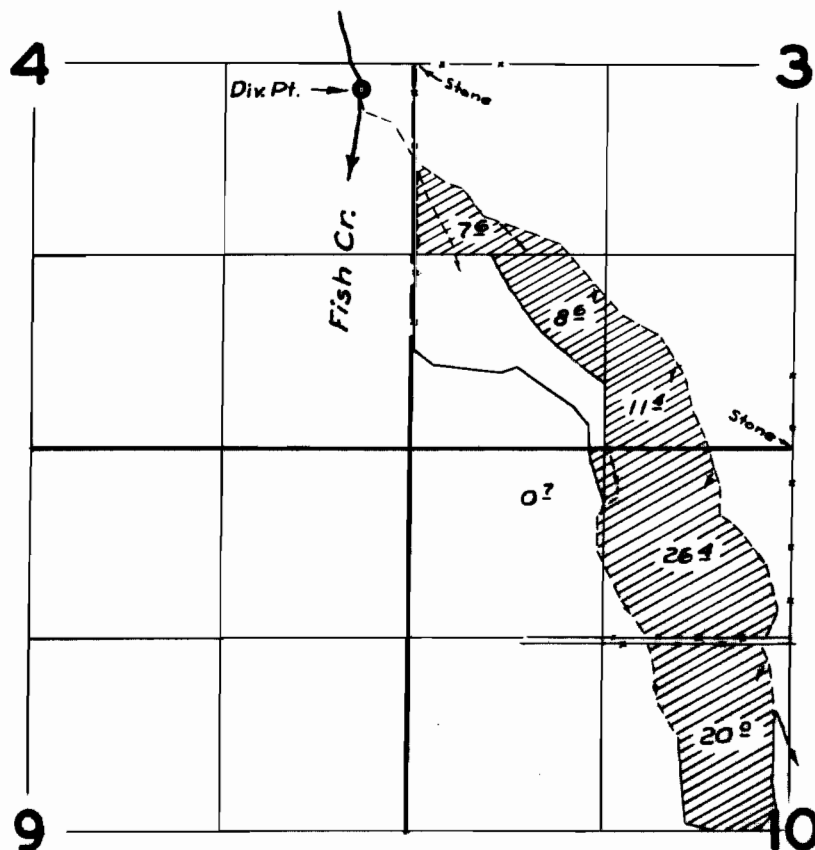


FINAL PROOF SURVEY
UNDER

Application No. 30490 Permit No. 25223
IN NAME OF

JAMES V. A. CARTER

Surveyed 22 Sept. 1959, by M. Bish

T.28S.R.45E.W.M.

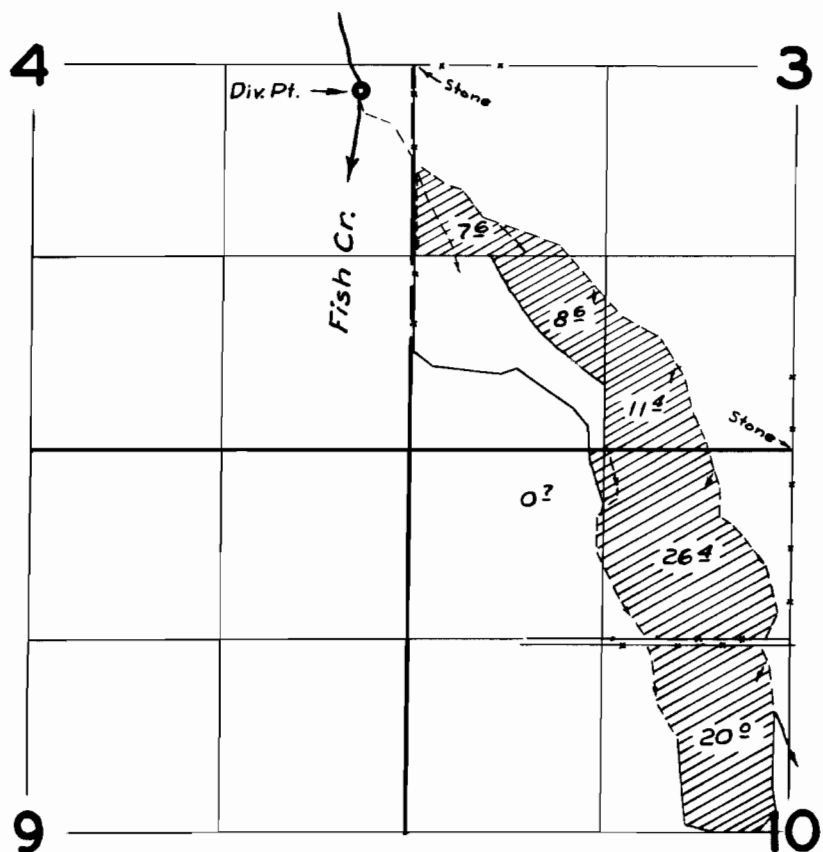

FINAL PROOF SURVEY
UNDER

Application No. 30490 Permit No. 25223
IN NAME OF

JAMES V. A. CARTER

Surveyed 22 Sept. 1959, by M. Bish