


# T.21 S.R.47 E.W.M.

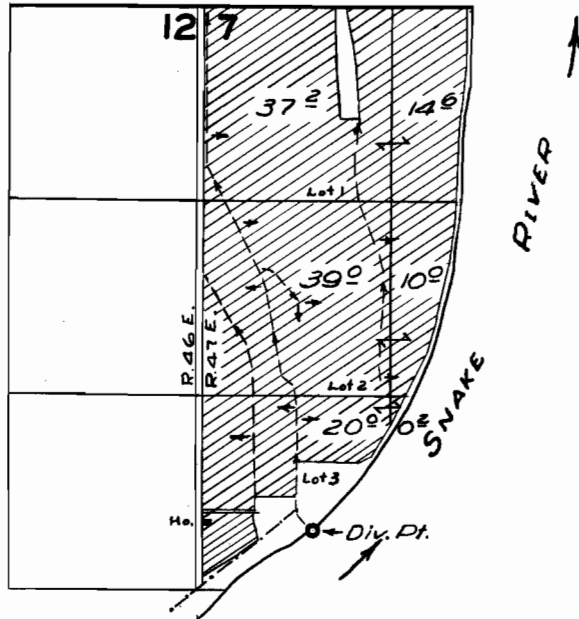

## FINAL PROOF SURVEY UNDER

Application No. 31646 Permit No. 25513  
IN NAME OF

H. L. HOLLAND

Surveyed 17 Sept. 1959, by Tom Bick