


T. 2S. R. 2E. W.M.

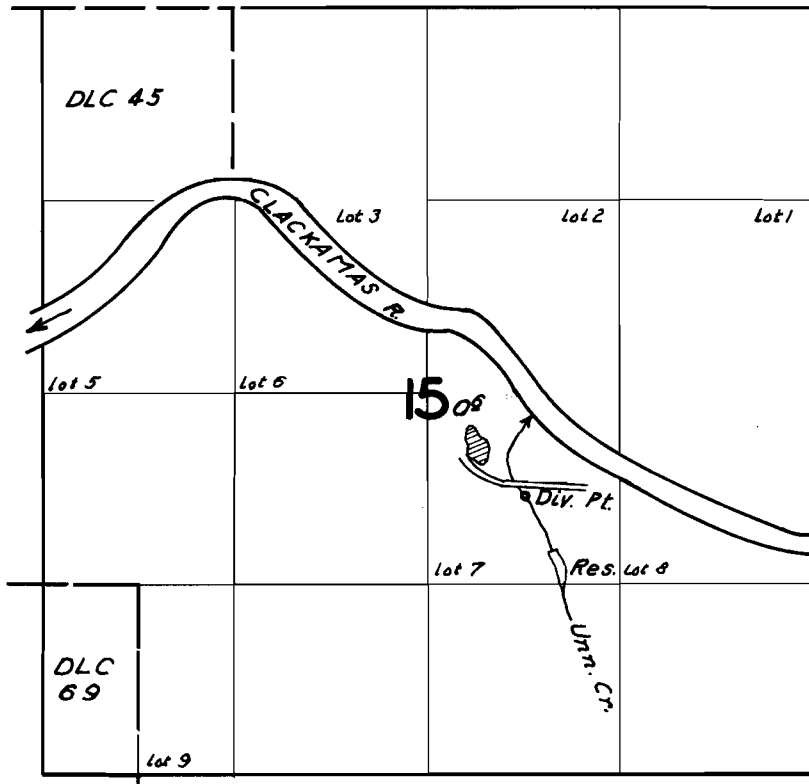

FINAL PROOF SURVEY
UNDER

R30345 R1815
Application No. 30412 Permit No. 23955
IN NAME OF

Guy & Gertrude L. Mount

Surveyed Sept. 8, 1950, by C. O. Bartels