


KENT PRICE WATER RIGHT

SEC 19, T4N, R10W. CLATSOP CO.

SCALE 1" = 400'

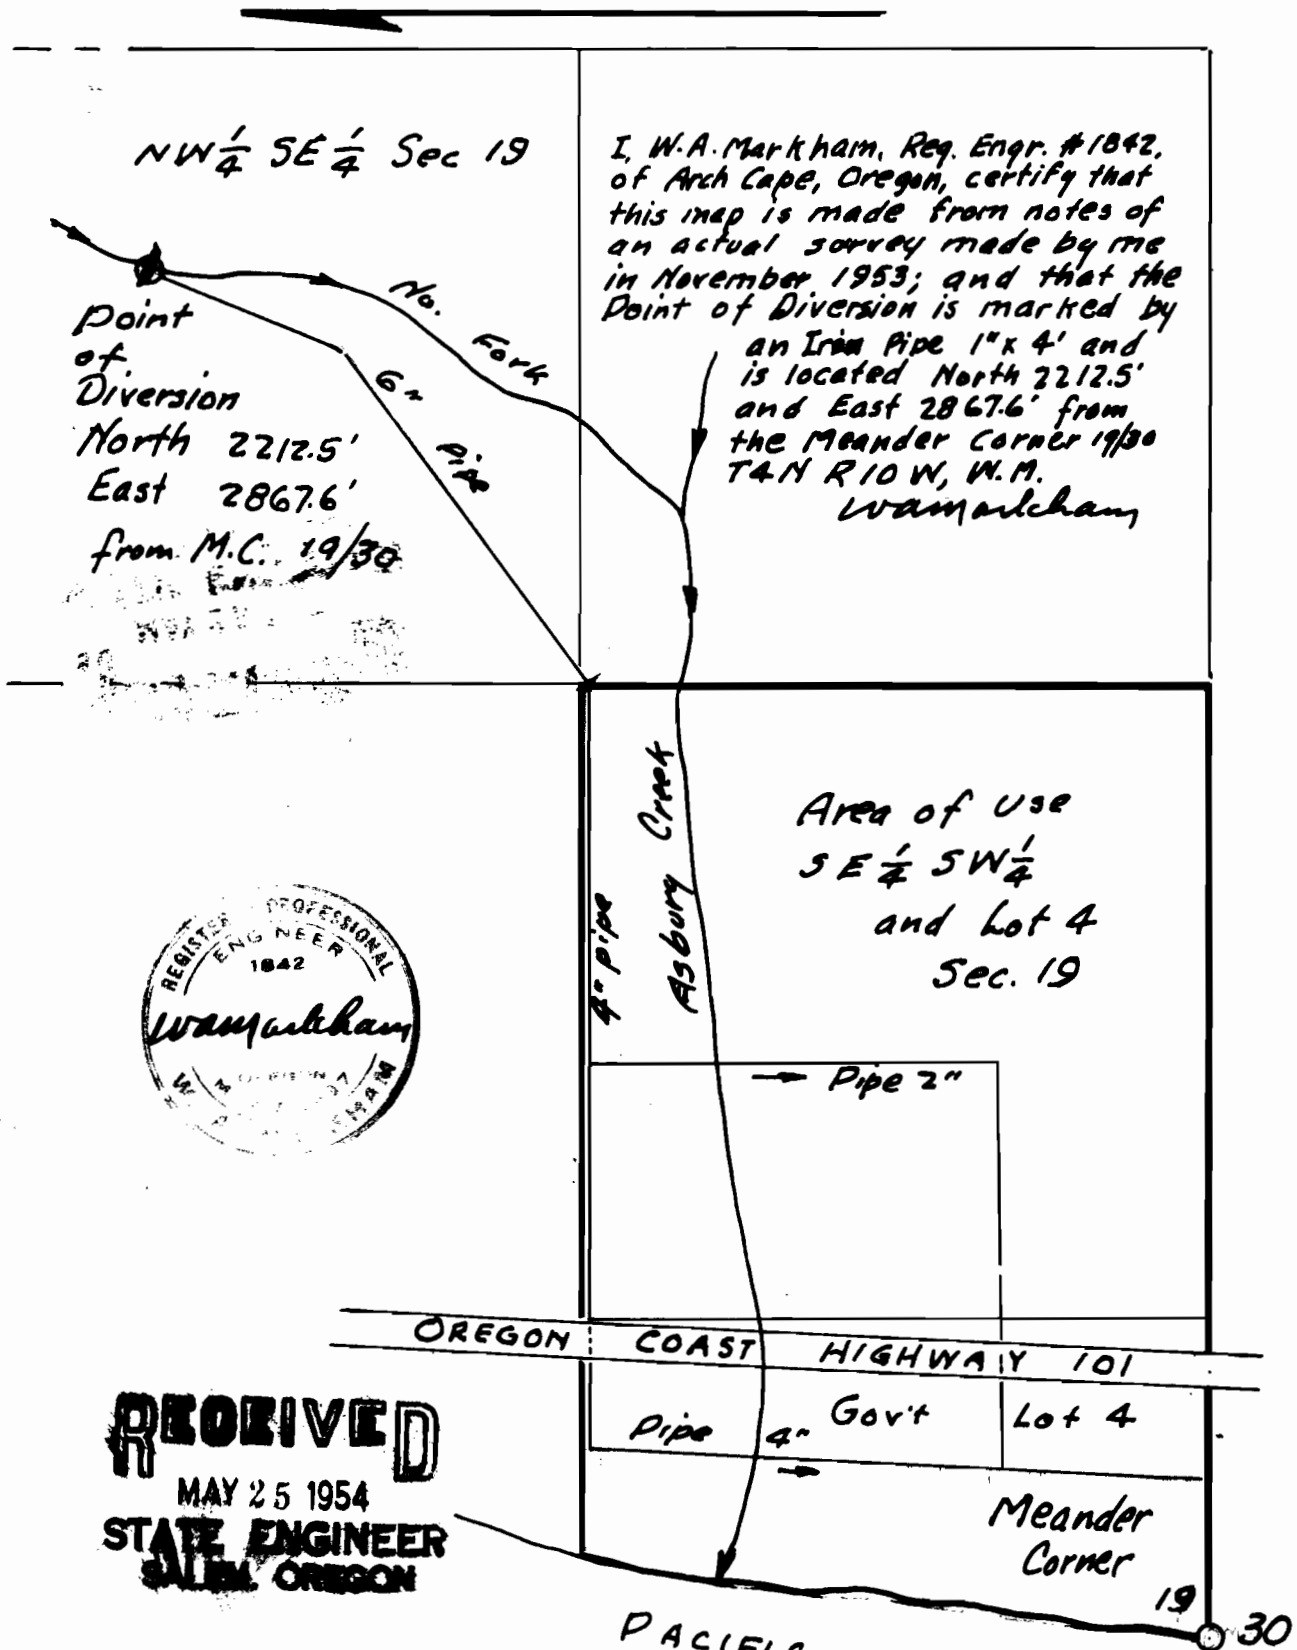

RECEIVED
MAY 25 1954
STATE ENGINEER
SALEM, OREGON

PACIFIC OCEAN
Application No. R-29112 29198
Permit No. R-11112 & 22996