


This distance appears to
be in error.
9-4-86 Jim Carver

JOHN ELIASSEN WATER RIGHT

GOVT. LOT 3, SEC 7, T4N, R10W

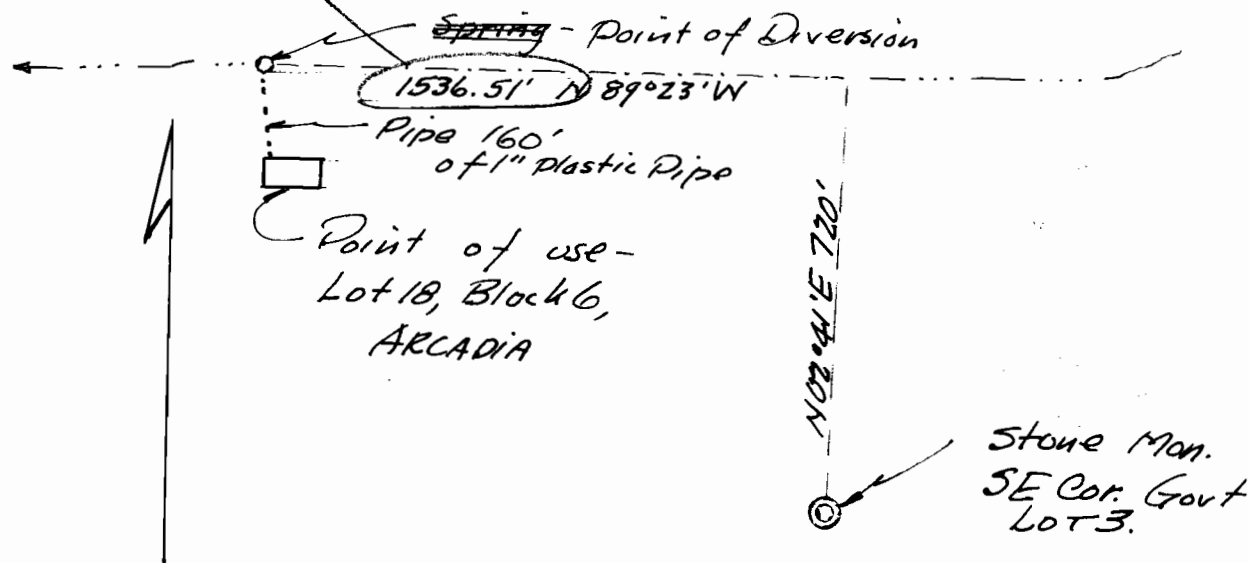

I, W. A. Markham, of Arch Cape Oregon, do hereby certify
that this map was made from notes of an
actual survey made by me July 1954.

W. A. Markham

Application No. 32245
Permit No. 25542