Township 8 S ,

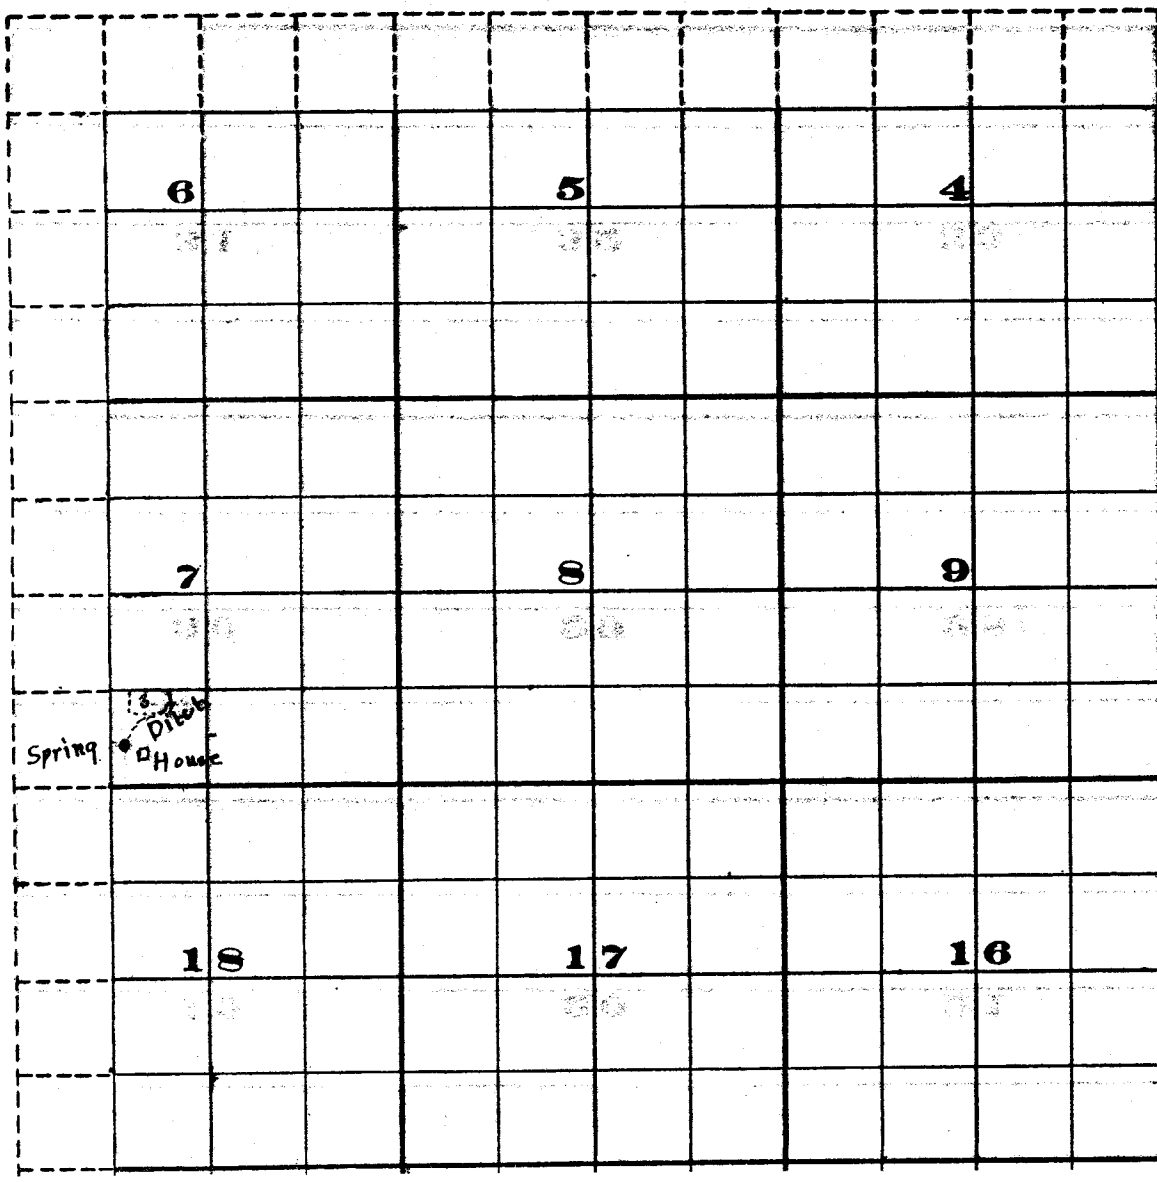
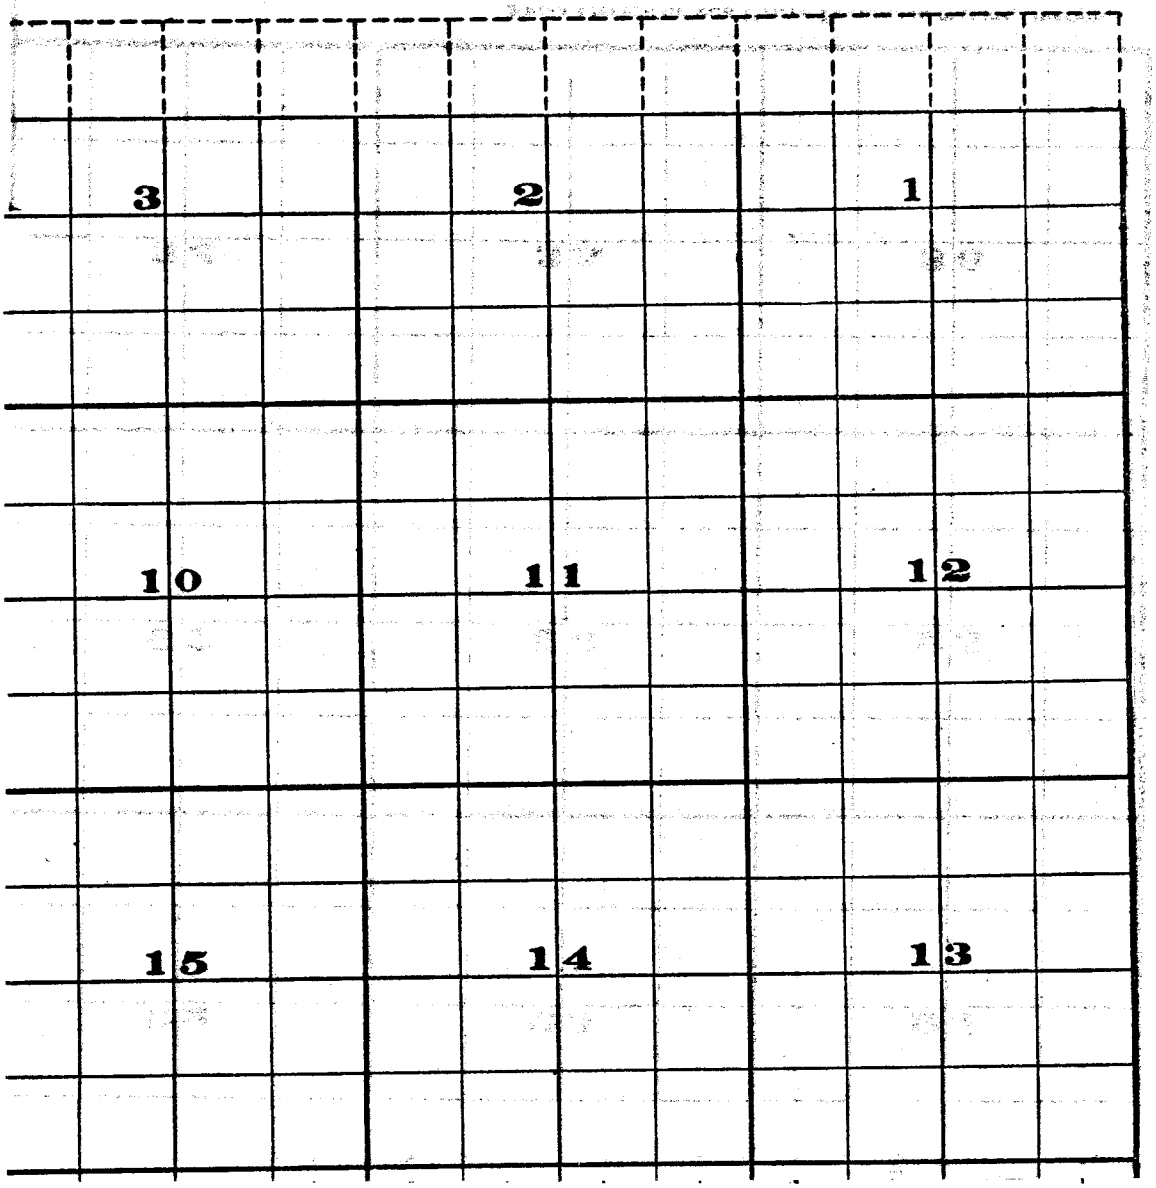
Range 3 W.