


SCALE - 1" = 100'

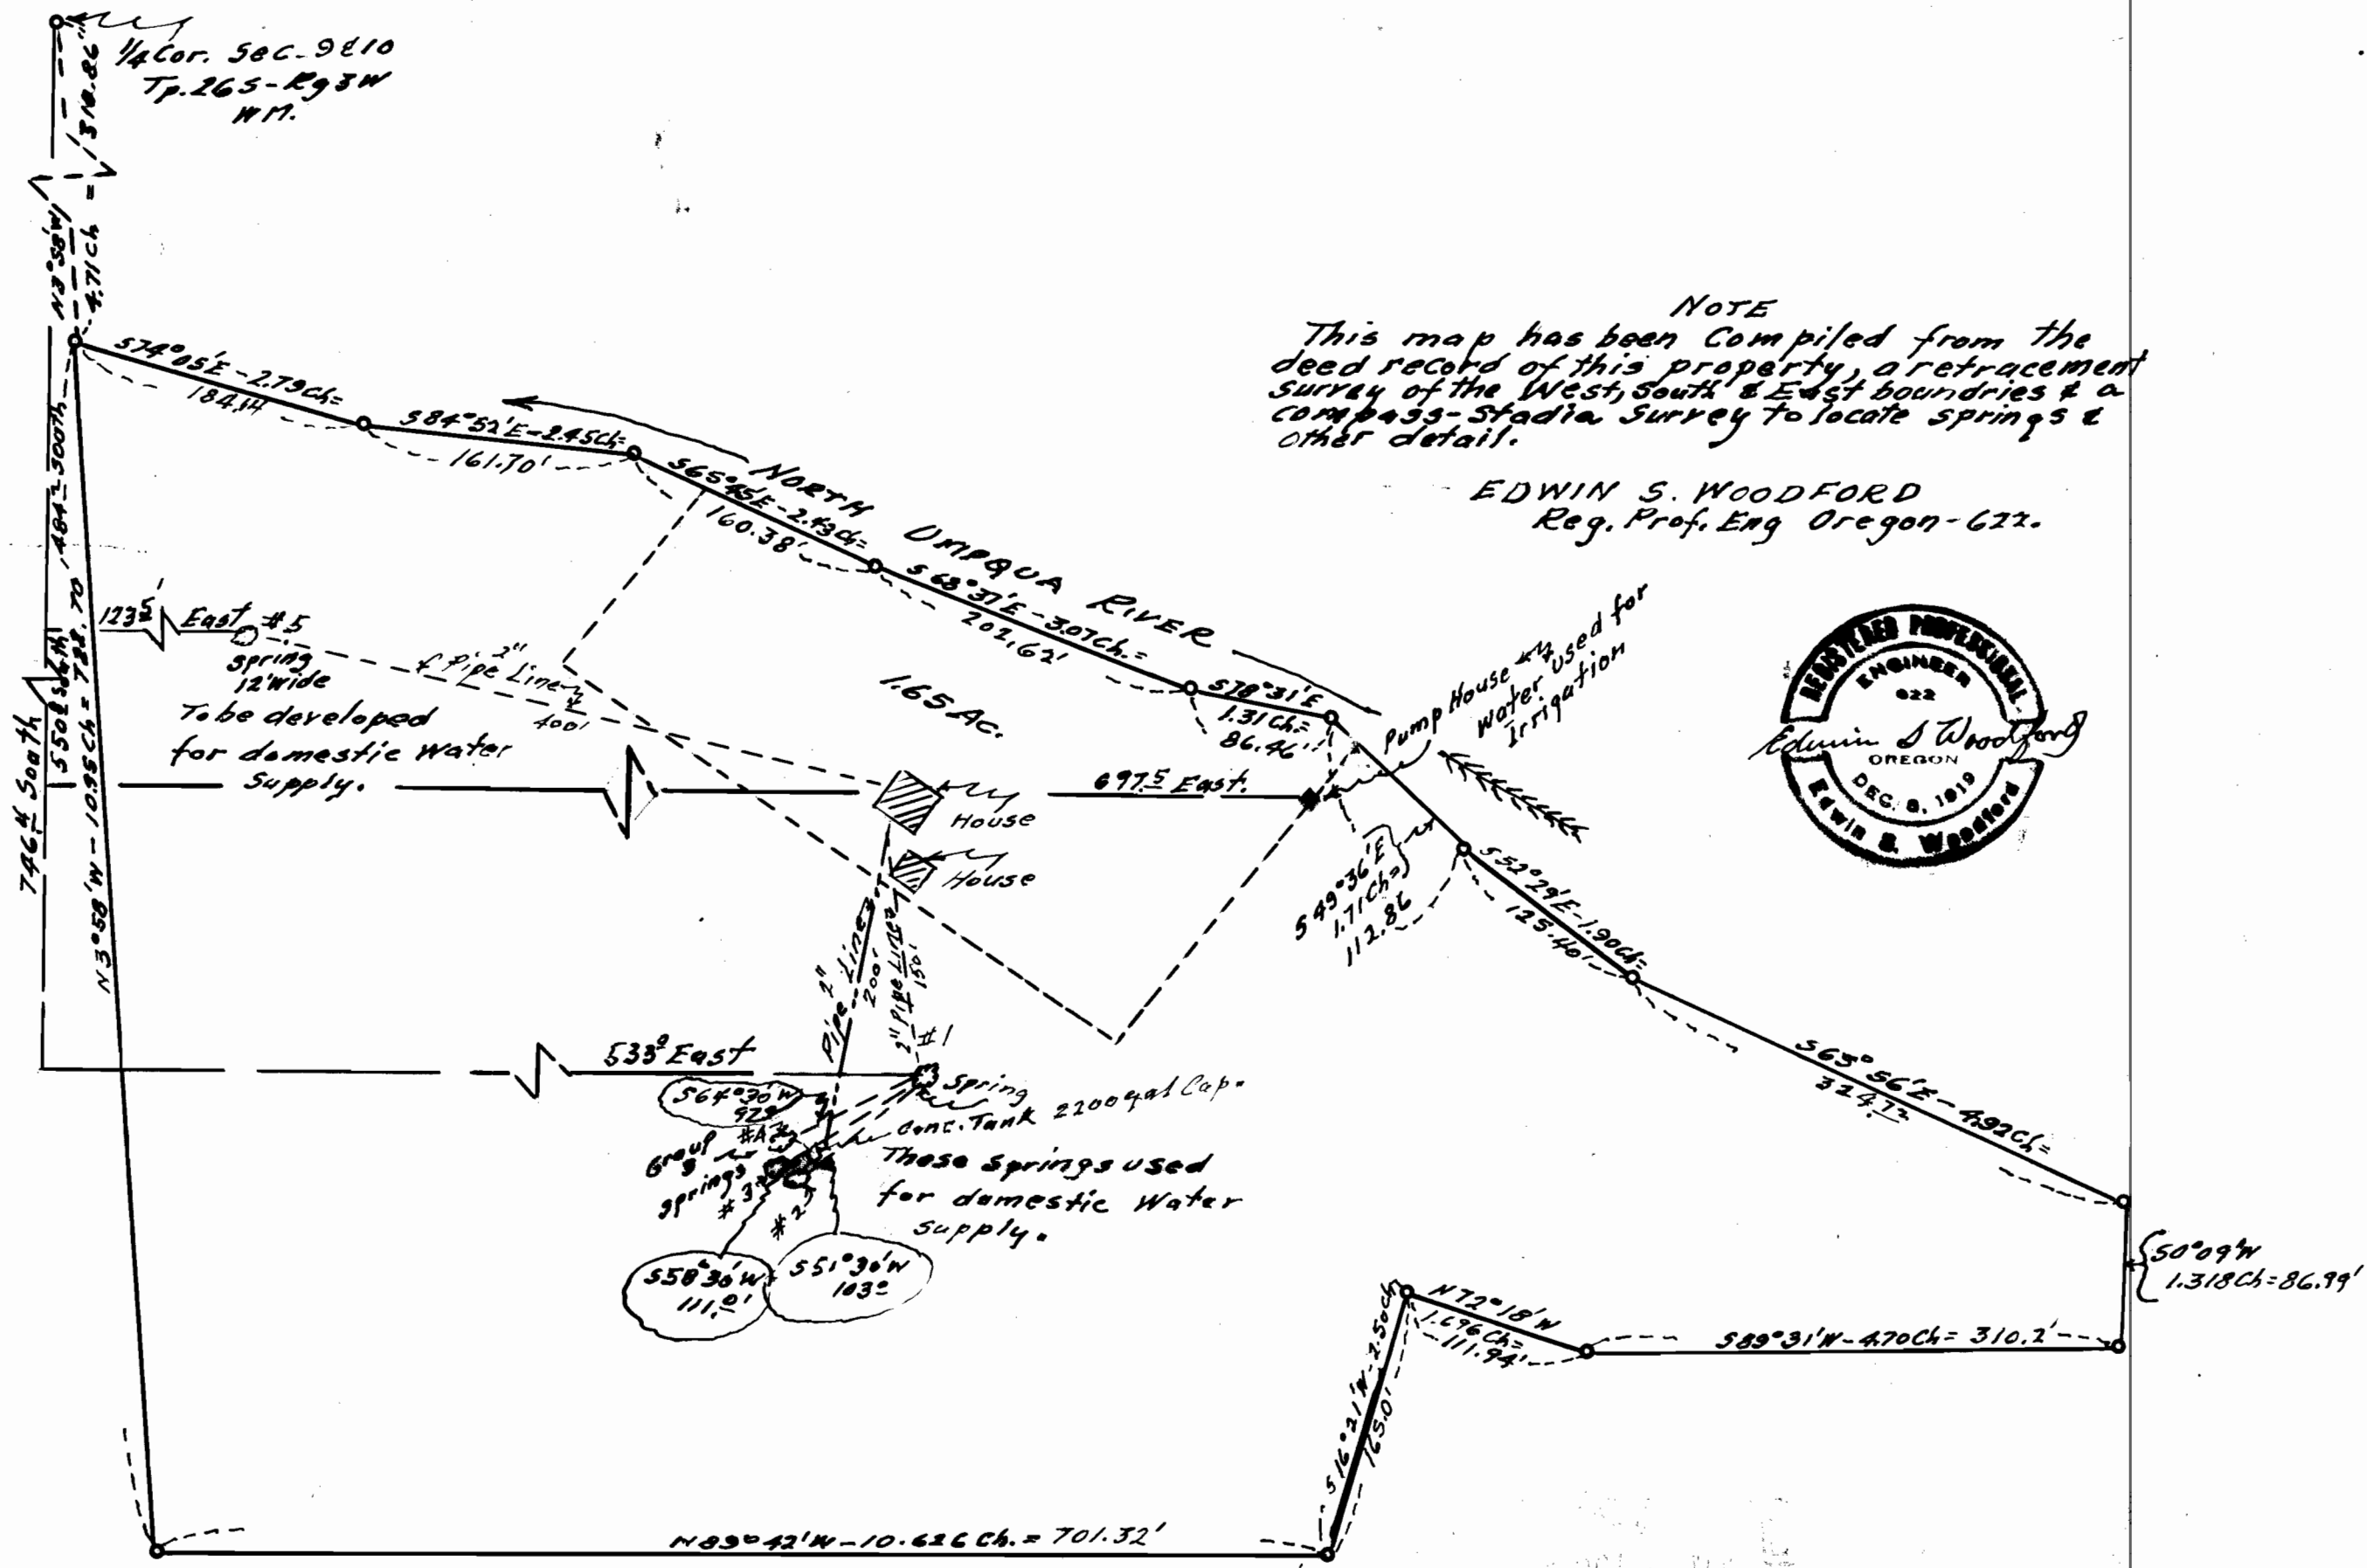

Application No. 32656
Permit No. 25791

STATE ENGINEER
SALMON DIVISION