


T. 23 S. R. 32 E. W.M.

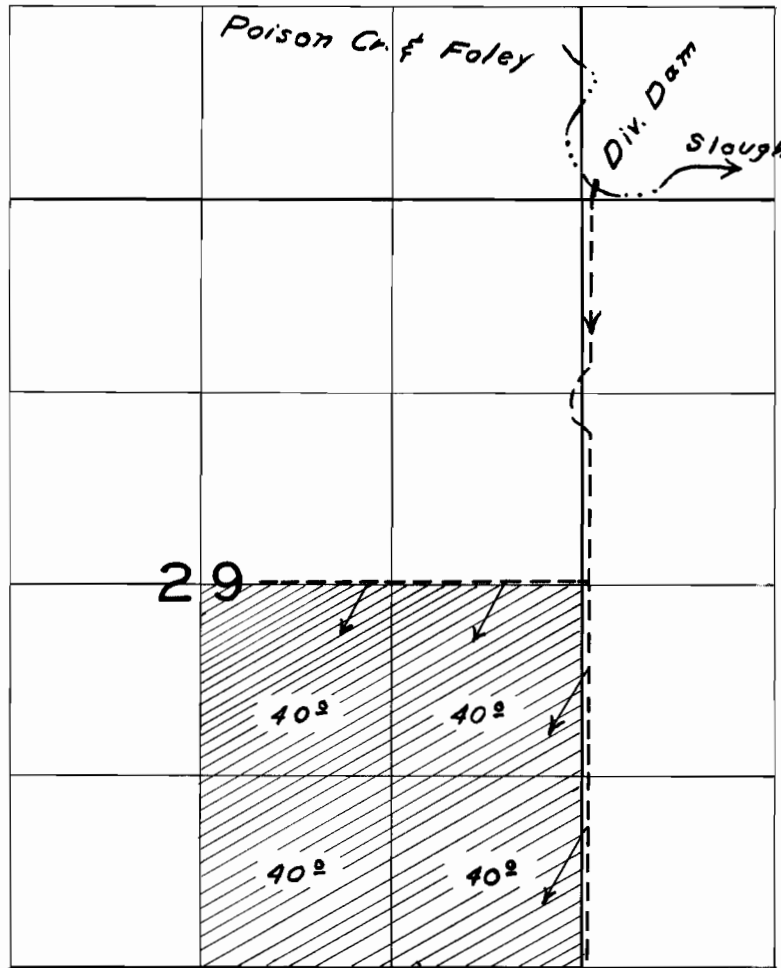

FINAL PROOF SURVEY
UNDER

Application No. 25878 Permit No. 20537
IN NAME OF

Treffle Joseph Duhaime

Surveyed July 21, 1958, by W.M. Perry