


RECEIVED
JUL 30 1953
STATE ENGINEER
SALEM, OREGON

T. 35 S. R. 7 W., W.M.
Scale 4" = 1 Mile. July 1953.
Harold E. Trowbridge

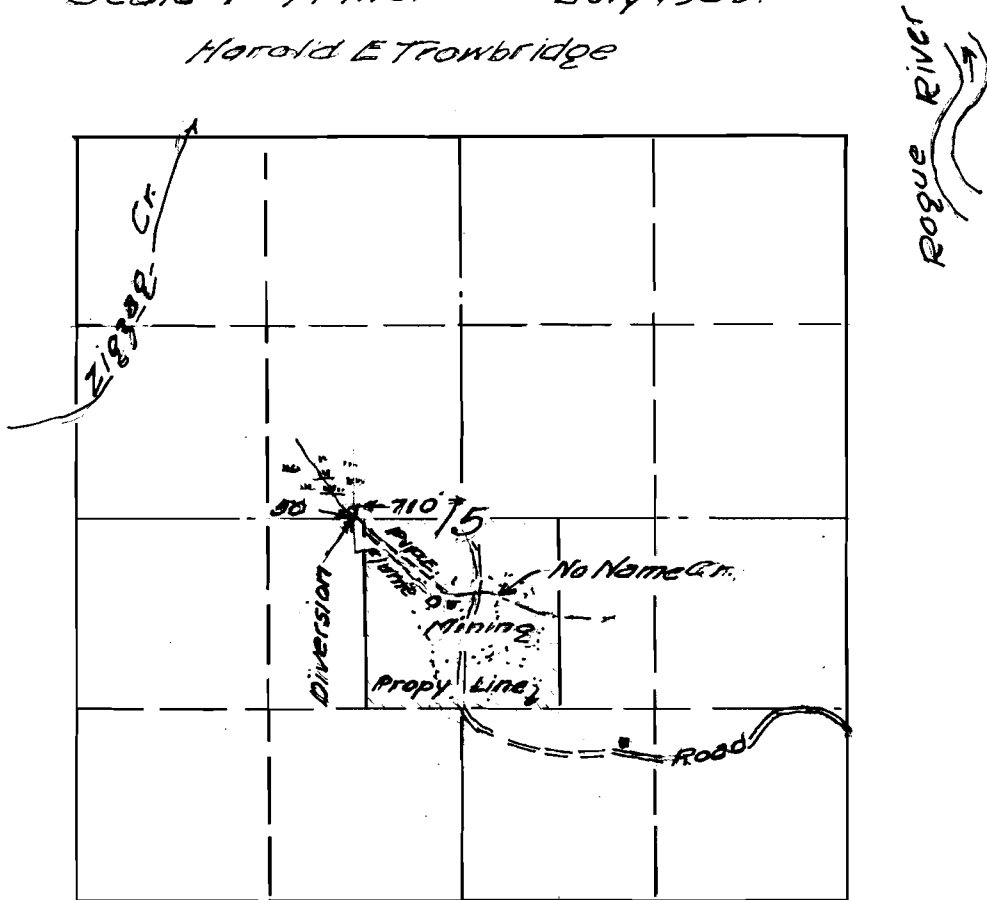

Application No. 28669
Permit No. 22576