


T. 37 S. R. 5 W. W. M.

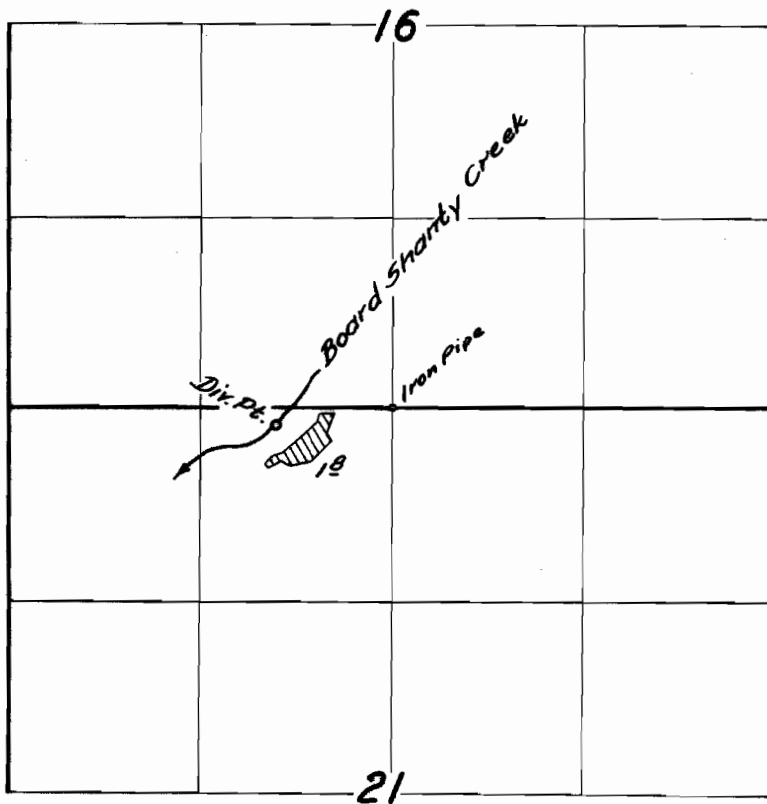

FINAL PROOF SURVEY

UNDER

Application No. 30006 Formit No. 23631

IN NAME OF

Alvin L. & Dorothy L. Anderson

Surveyed July 21 1959, by CR Butler