

CERTIFICATE
of
DEDICATION

WOLF CREEK


KNOW ALL MEN BY THESE PRESENTS, that we W.G. Smith & Florence D. Smith, his wife, of Lane Co. Ore. do hereby declare, certify and acknowledge that the within plat of a portion of the NE 1/4 of the NE 1/4 of the NE 1/4 of the NW 1/4 of Sec 22, T33S, R6W, M. a portion of the SW 1/4 of the SE 1/4 of the SE 1/4 of the SW 1/4 of Sec 15, T33S, R6W, M. Willamette Meridian, to be known as WOLF CREEK, Ore. being a replat of the original Townsite of Wolf Creek, Ore. plat of which is on file with the County Clerk of Josephine Co. containing 38 Acres more or less, with Tract 86 of Wolf Creek Orchard Tracts, containing 8 Acres more or less, added, as Block F and more definitely described as follows: Beginning at a point 310 ft. S. of N.W. Corner of NE 1/4 of NW 1/4 Sec 22, T33S, R6W, W.M. thence S. 410 ft. to Wolf Creek, thence following Wolf Creek in an easterly and northeasterly direction to intersection of Southern Pacific Ry. 2947 ft. thence West 2202 ft. along S.P. Ry. Right of Way to quarter section line 21 ft. S. of 1/4 corner above mentioned, thence 289 ft. to starting point, containing 38 Acres, more or less, is a true and correct map of said premises, as the same has been surveyed and platted, and that it correctly indicates the corners, lines and dimensions of the streets and lots thereon, that we hereby dedicate to the County of Josephine, State of Oregon, for public use any and all streets shown by the within map, and by the affidavit of Survey hereto annexed.

In Witness whereof, we have hereunto set our hands and seals, this 2nd day of June 1913.
W.G. Smith Witness
Florence D. Smith Seal
By W.G. Smith Attorney in Fact.

State of Oregon)
County of Josephine) S.S.
On June 2, 1913, Personally appeared before me, a Notary Public, in and for said County and State, the within named W.G. Smith and Florence D. Smith, by Attorney in fact, each to me personally known to be the identical persons described in the foregoing dedication of portions of NE 1/4 NE 1/4 and NE 1/4 NW 1/4 Sec 22, and of SW 1/4 SE 1/4 and SE 1/4 SW 1/4 Sec 15, T33S, R6W, W.M. and who executed the within dedication of the within parcels of land described and acknowledged to me that they executed the same freely and voluntarily, and for the purposes herein named.
June 3, 1913.
L.L. Gaburn County Clerk

Examined and Approved this 3d day of June 1913
E. L. P. Assessor for Josephine Co. Ore.

This plat Examined and Approved this 7th day of August 1913 as complying with the requirements of Sec. 3269 U.O.L.
H. H. Hall Surveyor for Josephine Co. Ore.

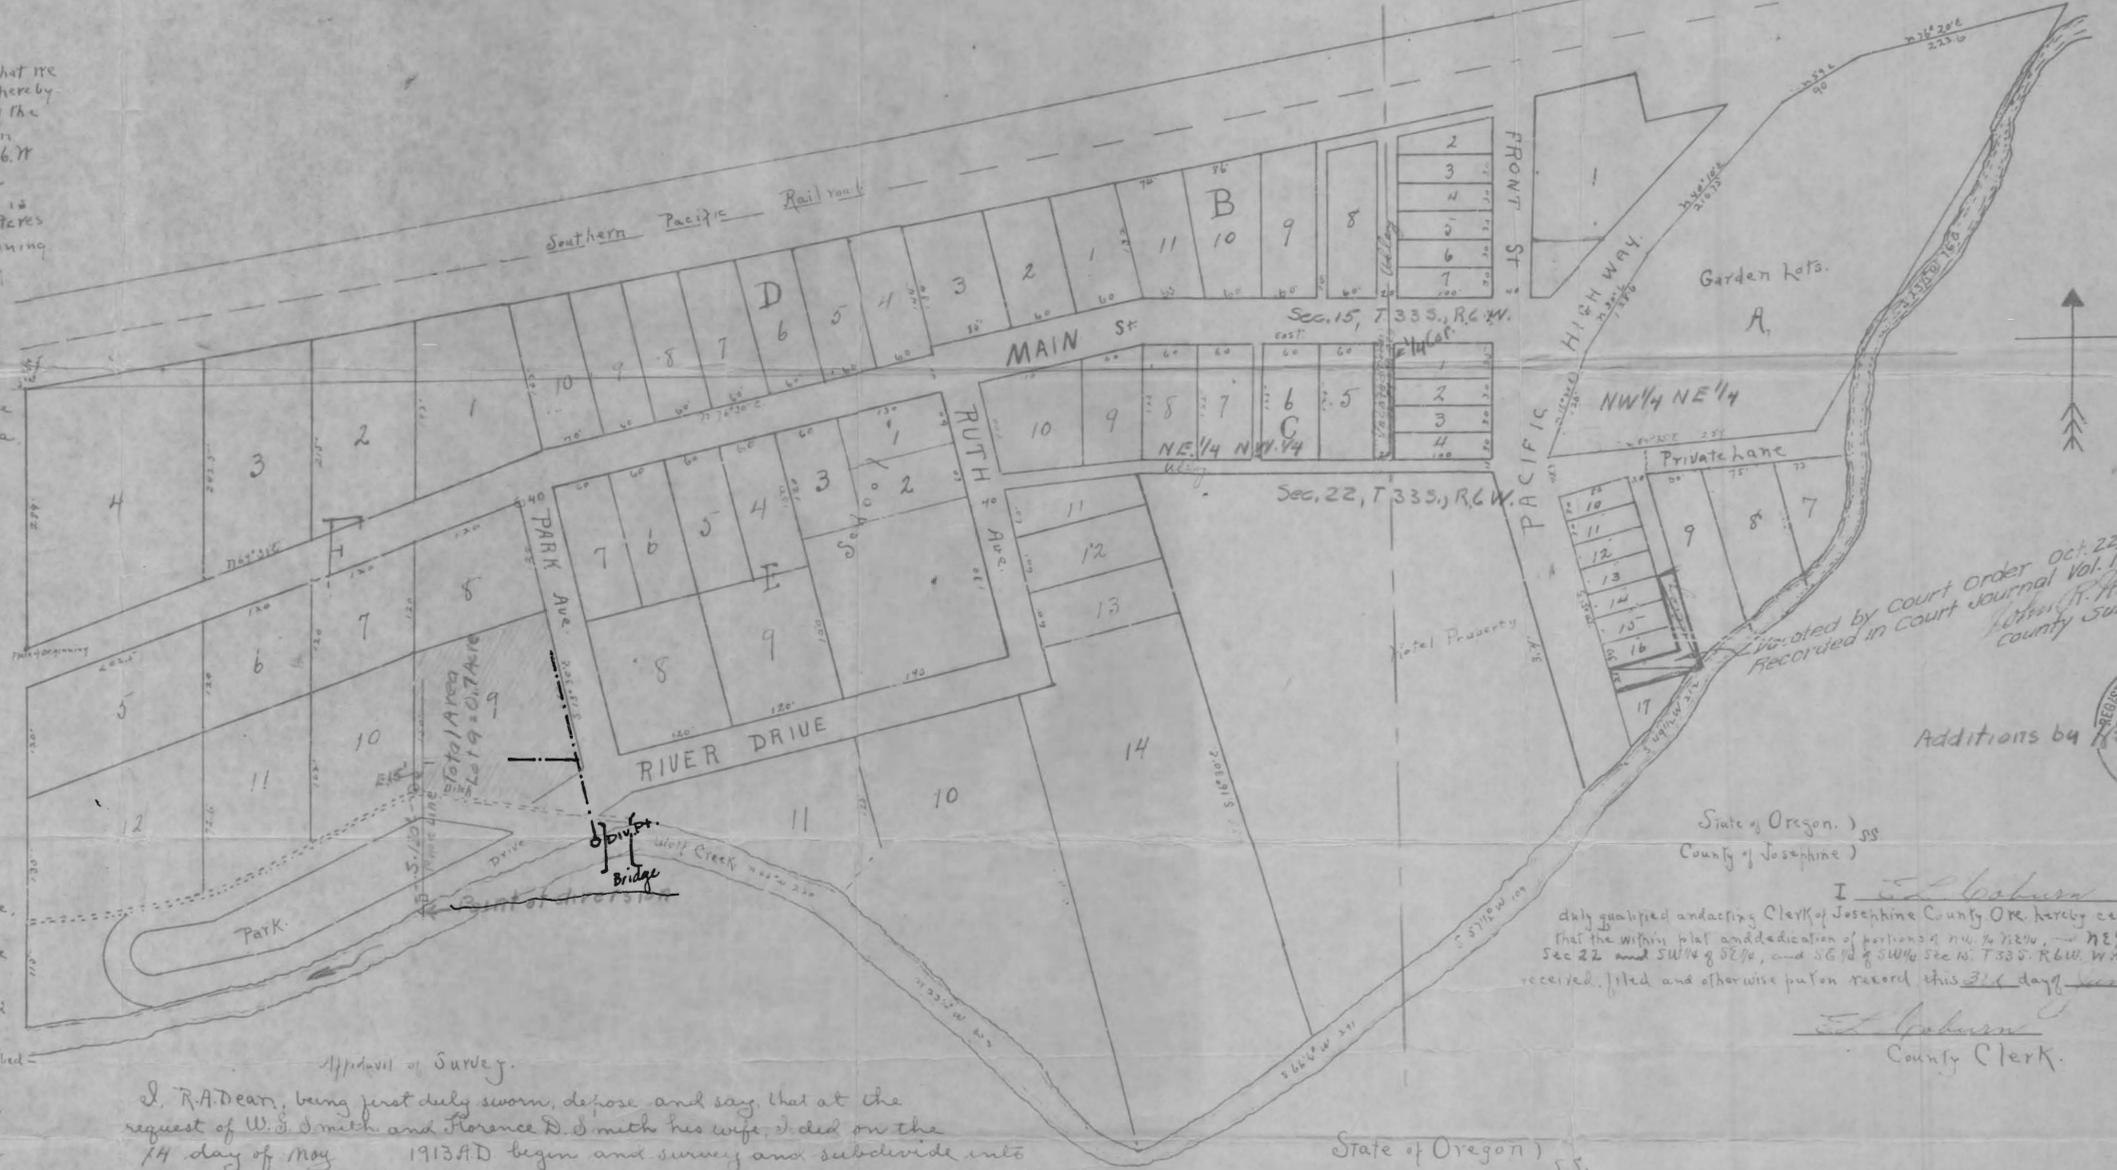

I, R.A. Dear, being just duly sworn, depose and say, that at the request of W.G. Smith and Florence D. Smith his wife, I did on the 14 day of May 1913 AD begin and survey and subdivide into blocks, lots and streets the following described premises, to-wit: Beginning at a point 310 ft. S. of NW. corner of NE 1/4 NW 1/4 Sec 22, T33S, R.6W, W.M. thence S. 410 ft to Wolf Creek, thence following Wolf Creek 2947 ft in an easterly and north-easterly direction to the intersection with the Southern Pacific Ry Right of Way, thence West 2202 ft to L.S. line above mentioned, 21 ft S of 1/4 corner, thence S. 289 ft. to starting point, containing in all, 38 Acres, more or less. The initial point of this survey is identified by an iron rod 2.5 ft set in the ground. That subsequent to the survey, I caused to be drafted the within plat of the same on a scale of 100 ft to the inch to indicate the survey and designate the lands as now subdivided and present for approval. That the blocks as lettered and lots as numbered are correct as herein indicated.

Subscribed and Sworn to before me this 3rd day of June 1913
L.L. Gaburn County Clerk

State of Oregon) S.S.
Josephine County)
Be it remembered, that on this 2nd day of June 1913 this matter came to be heard upon the application of W.G. Smith and Florence D. Smith to have the COUNTY COURT approve and adopt this Survey and plat of the subdivision of the within described lands owned by the above named parties, and the Court being fully advised from the records and otherwise finds that the lands were duly surveyed and platted according to Chapter 70 of the session laws of 1909 (Senate Bill 114), it is hereby considered and ordered that said survey and plat be and is hereby approved, and that the County Clerk place the same on file and record in his office.
County Judge
County Commissioner
County Commissioner
County Court Attest
County Clerk

Recorded in Court Journal Vol. 11, Page 29.
L. H. H. County Surveyor

