



G-467
27529

Permit No. G-467

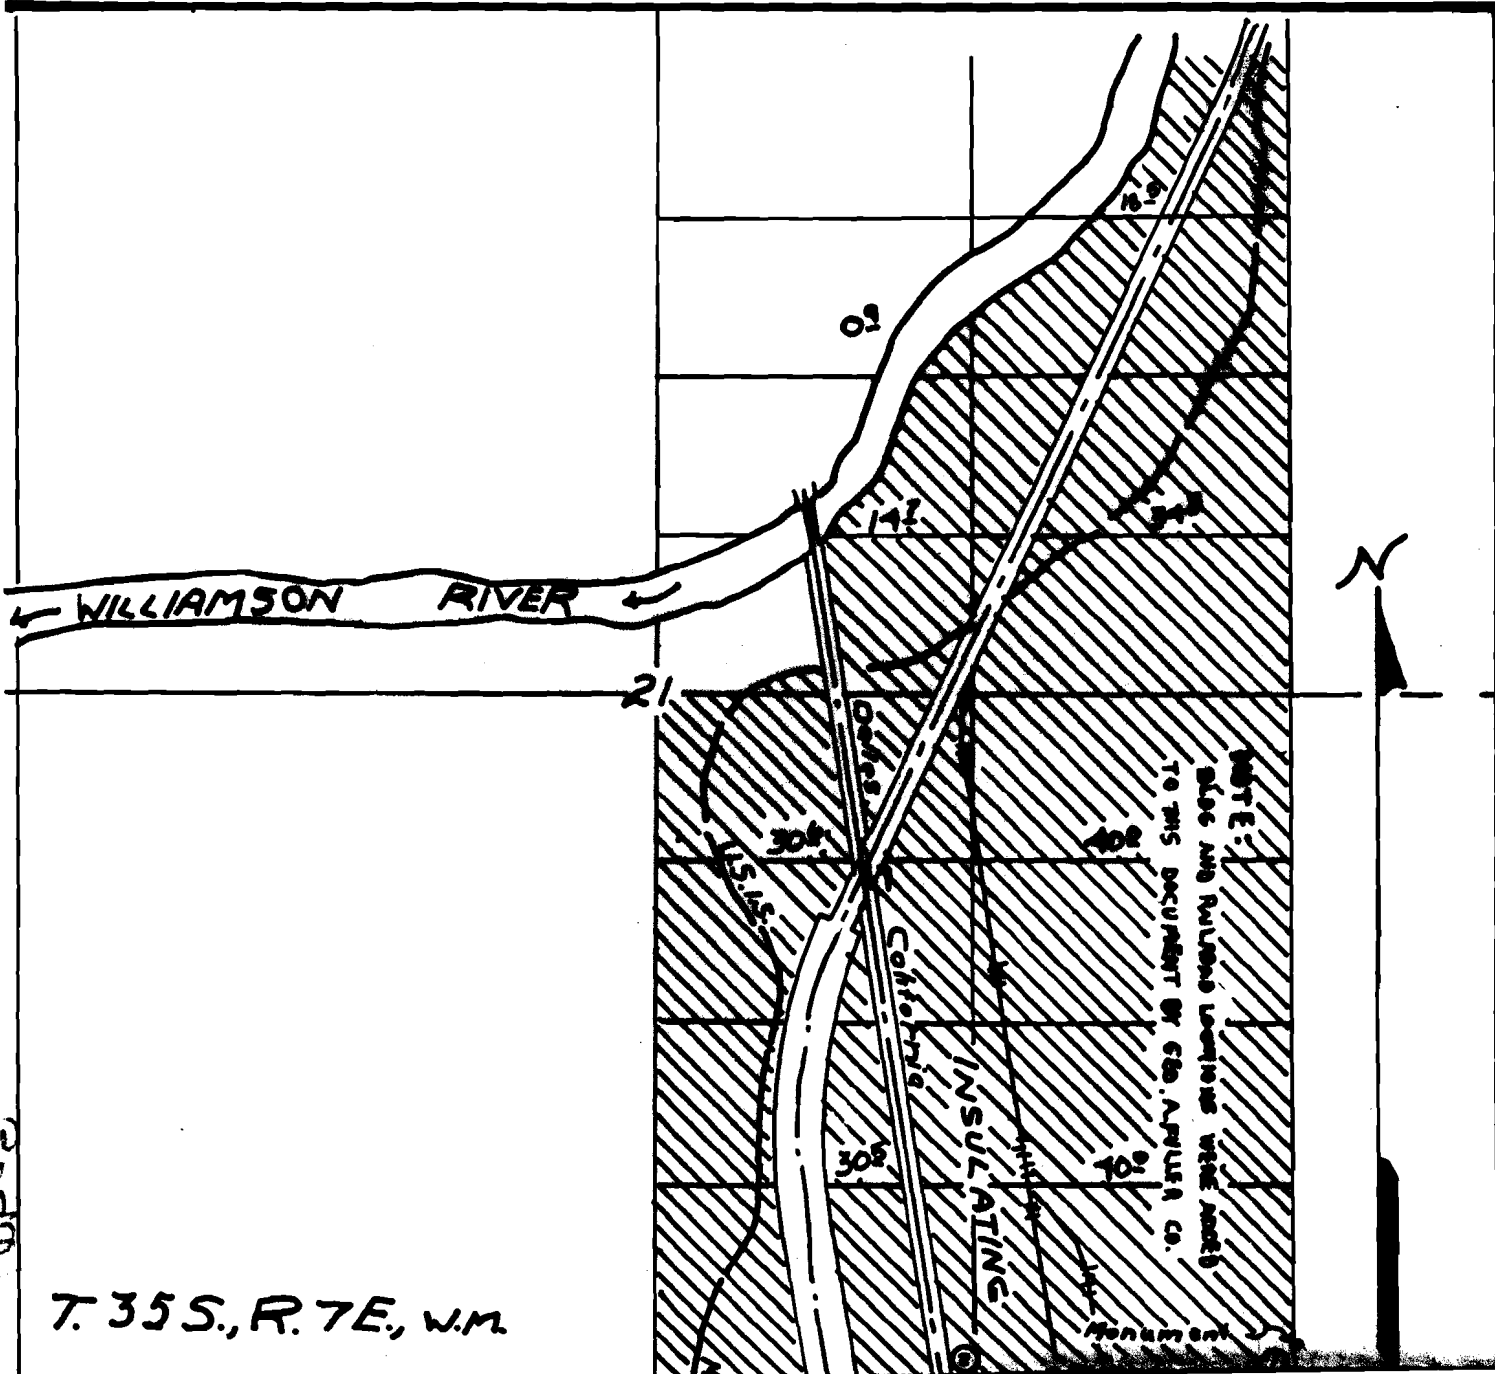

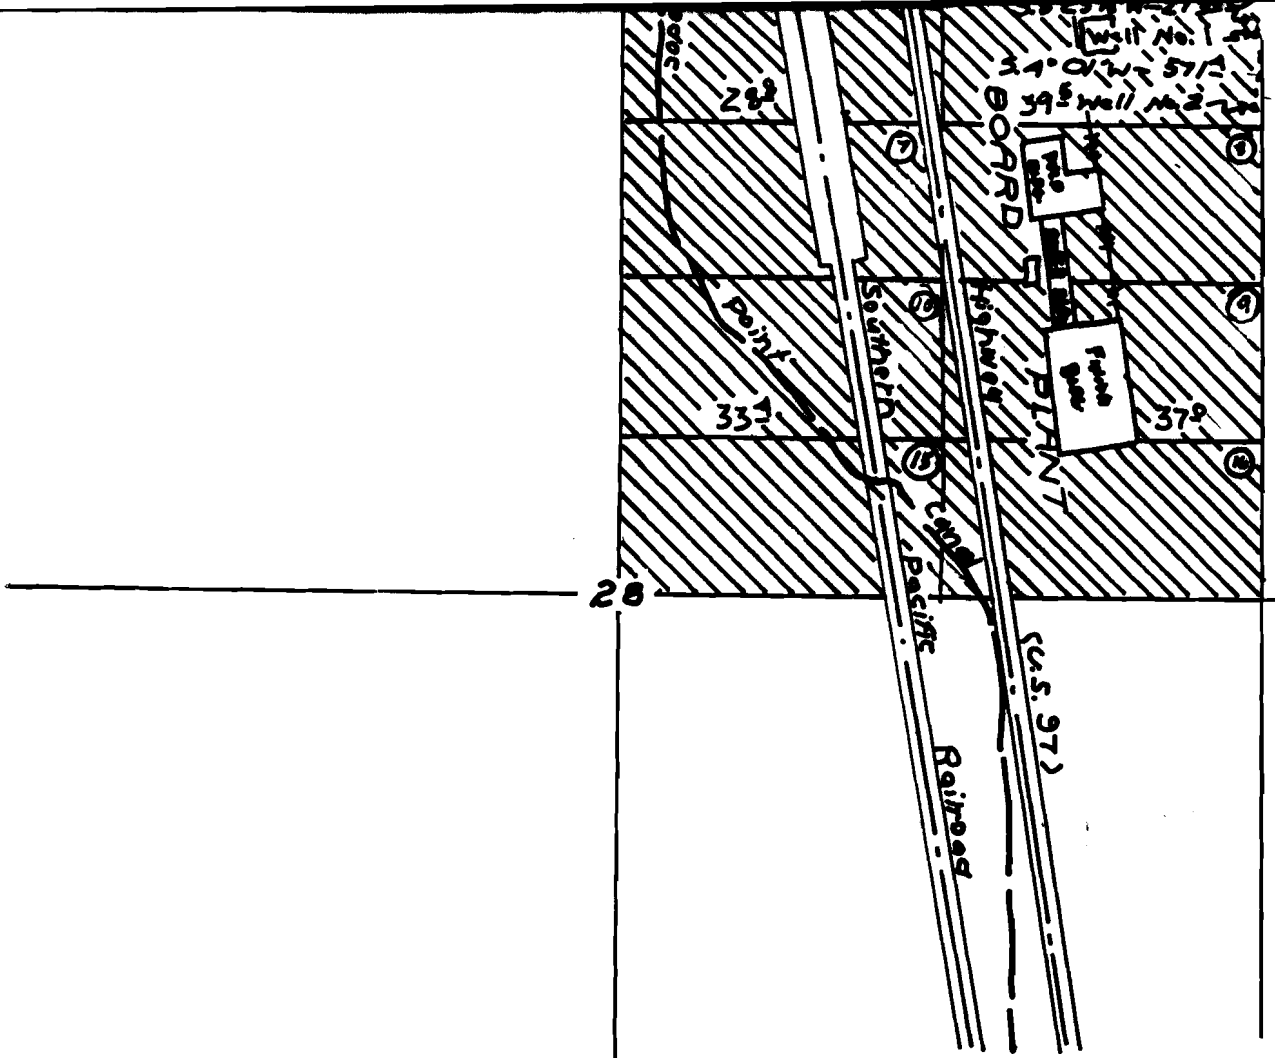

MAP SHOWING
 LOCATION OF WELLS FOR WATER SUPPLY
 INSULATING BOARD PLANT
 JOHNS-MANVILLE CORP
 OF OREGON
 KLAMATH COUNTY, OREGON
 Scale: 1"=800'