


G-731
27530


FIRST St.

N.

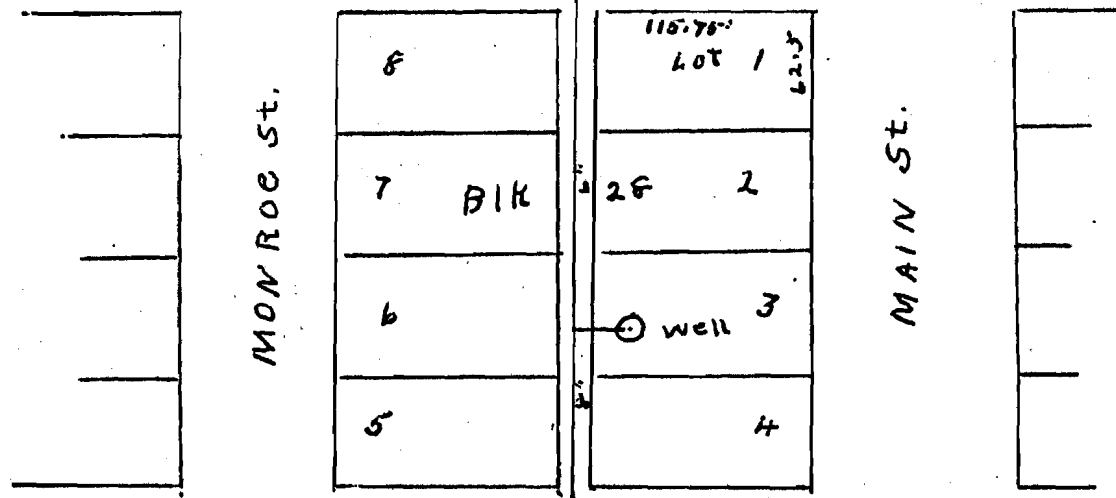

W. 6" 80' 8" PIPE FRONT St. 2' 9" SEC. 11' 12' E


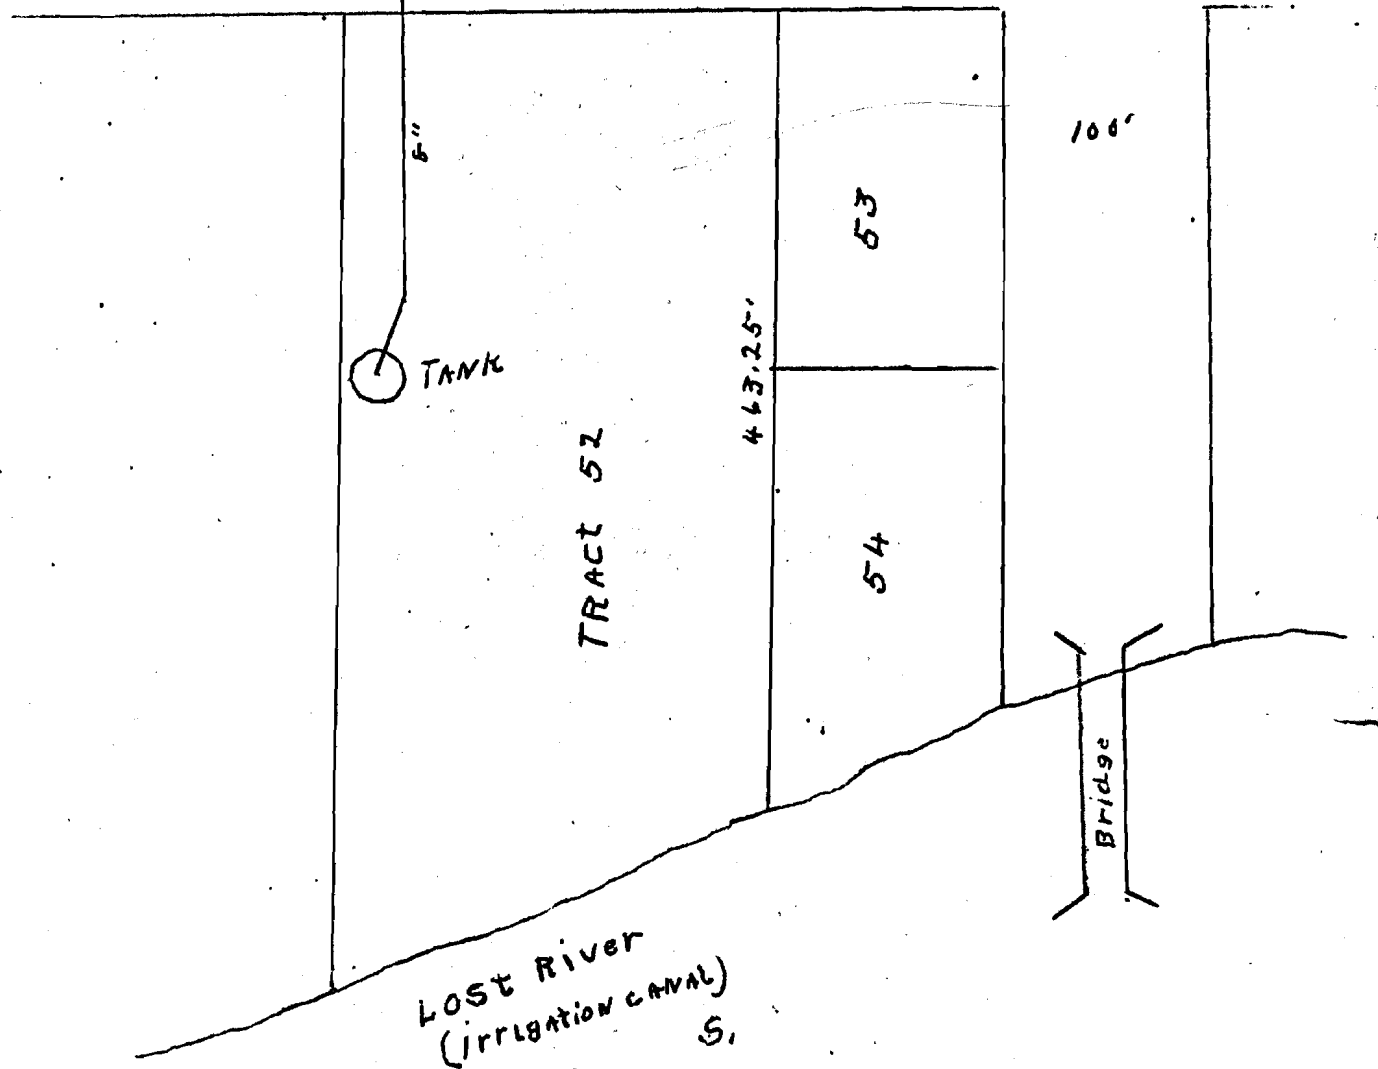

LOST RIVER
(IRRIGATION CANAL)
S.

Appl. G-821
Per. G-731