


T. 38S. R. 9E. W.M.

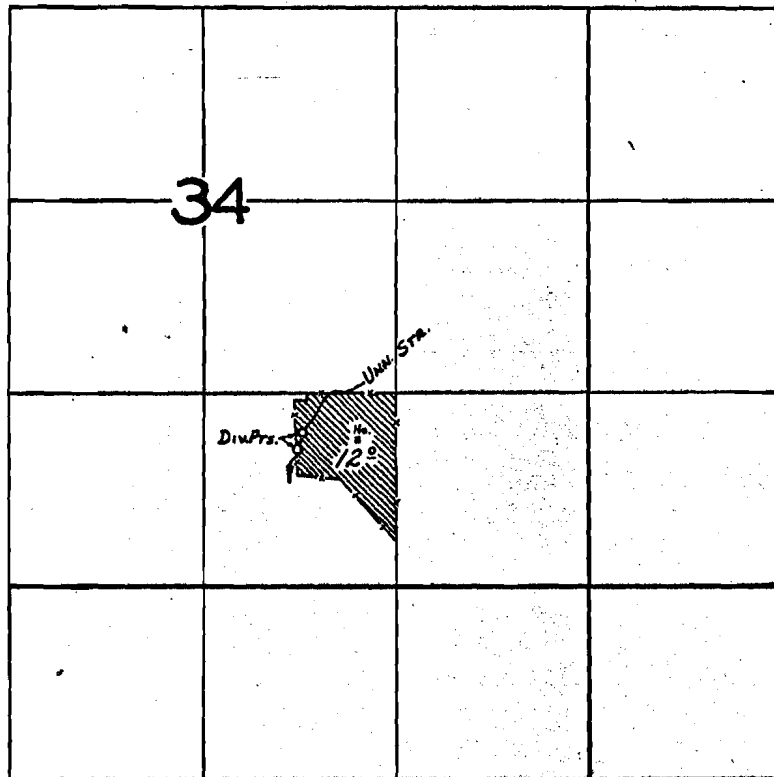

Klamath Res. Wash.

FINAL PROOF SURVEY UNDER

Application No. 29693 Permit No. 23380
IN NAME OF

JOHN & ARLETA FEHLEN

Surveyed Apr. 30 1958, by C. O. BARTELS