


23422

27534

T.39 S.R.8 E.W.M.

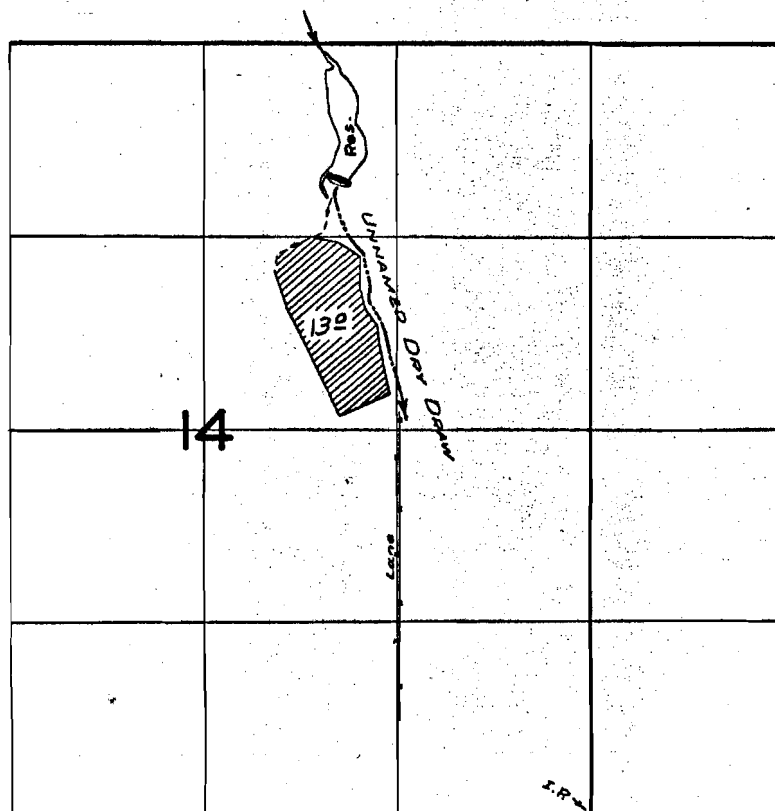

FINAL PROOF SURVEY

UNDER

Application No. R-22257 Permit No. R-1717
22258 23422
 IN NAME OF

PAUL A. & MAMIE BREITENSTEIN

Surveyed 29 Oct. 1959, by M. Bisher

1959-F