


T.39 S.R.8 E.W.M.

Klamath River Misc.

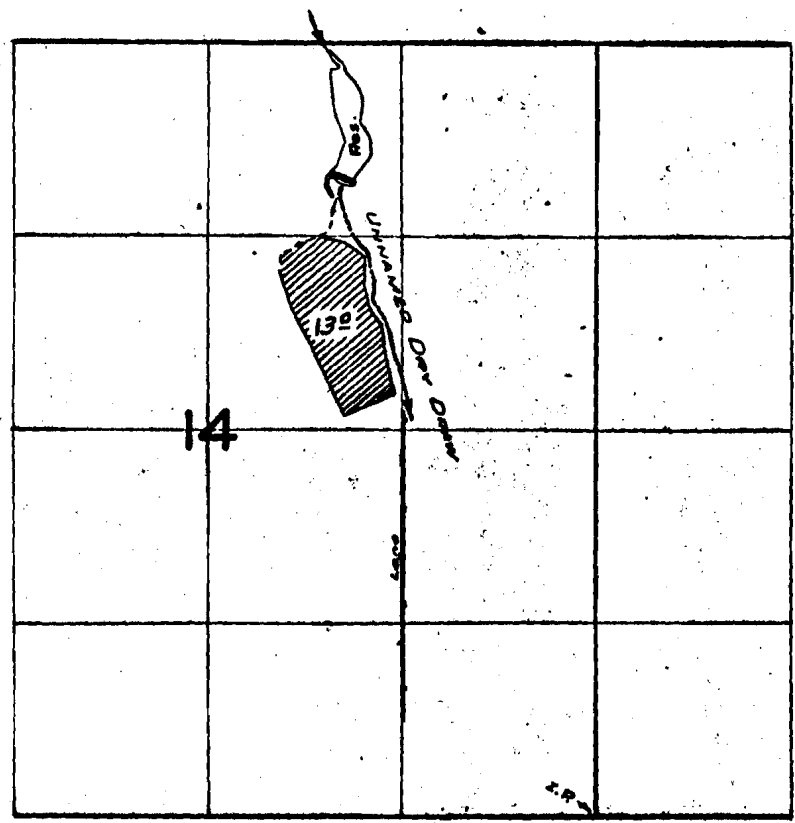

FINAL PROOF SURVEY  
UNDER

R-22257 R-1717  
Application No. 22258 Permit No. 23422  
IN NAME OF

PAUL A. & MAMIE BREITENSTEIN

Surveyed 29 Oct. 1959, by M. B. Bick