


T.27S.R.15E.W.M.

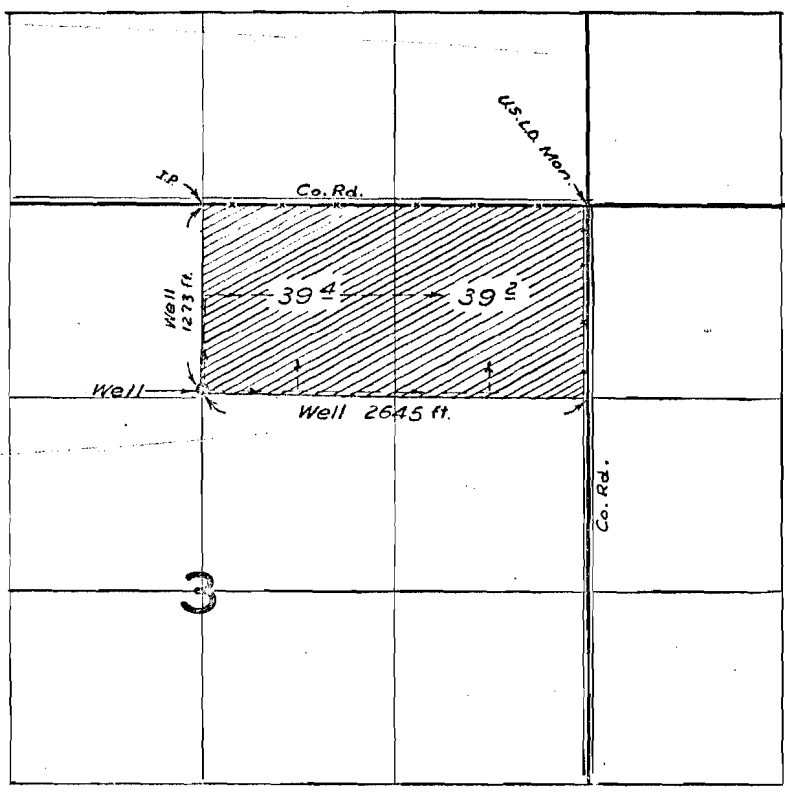

FINAL PROOF SURVEY UNDER

Application No. U-784 Permit No. U-710
IN NAME OF
Heavilin
LEONARD PITCHER

Surveyed 8 May 1959, by M. Bish