





T.17S. R.1W.W.M.

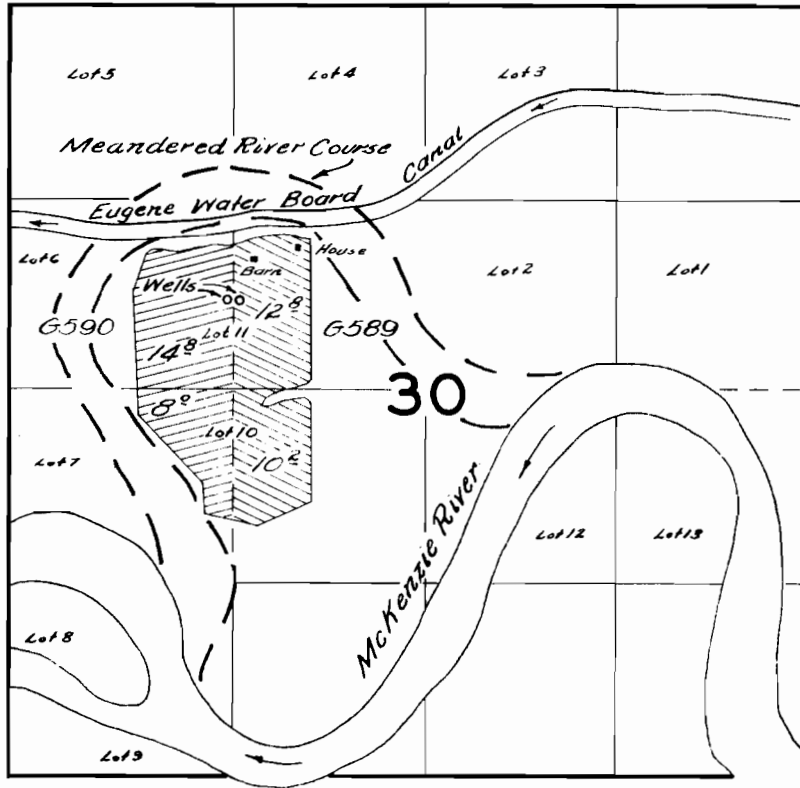

FINAL PROOF SURVEY UNDER

Application No. *G-589* Permit No. *G-497* 
G-590  *G-498* 
 IN NAME OF

Glenn L. LeVee
Loren A. & Irene T. Skirvin
 Surveyed April 7 1959 by *C.O. Bailets*