


T.16S. R.5W.W.M.

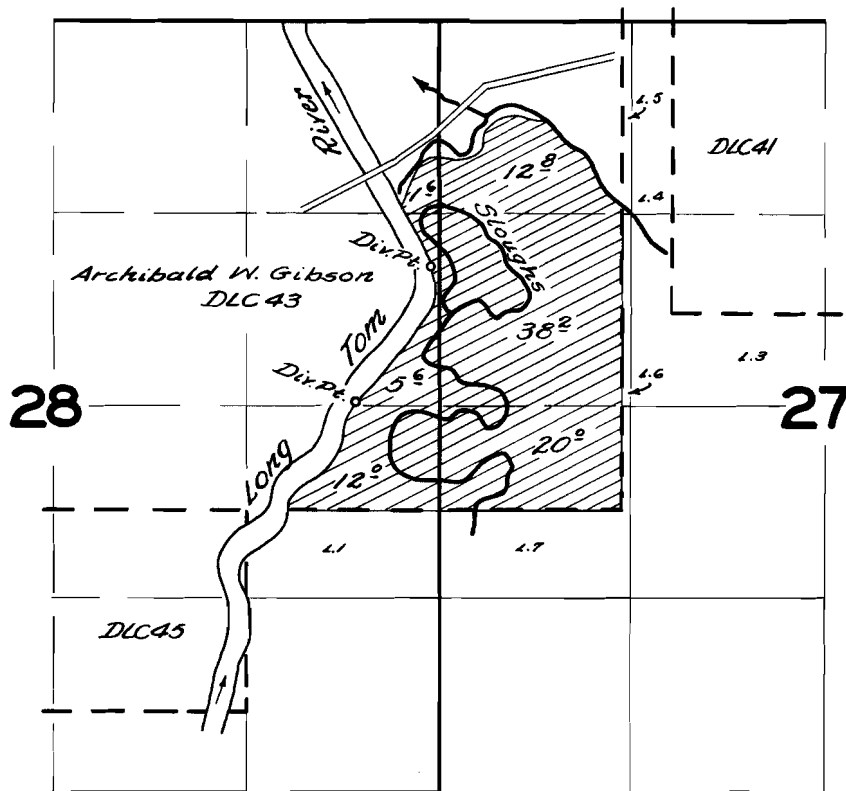

FINAL PROOF SURVEY
UNDER

Application No. 27505 Permit No. 22636
IN NAME OF

Jonathan S. & Joyce Holmes Benjamin

Surveyed April 2, 1959, by *C.D. Baile*