


Township

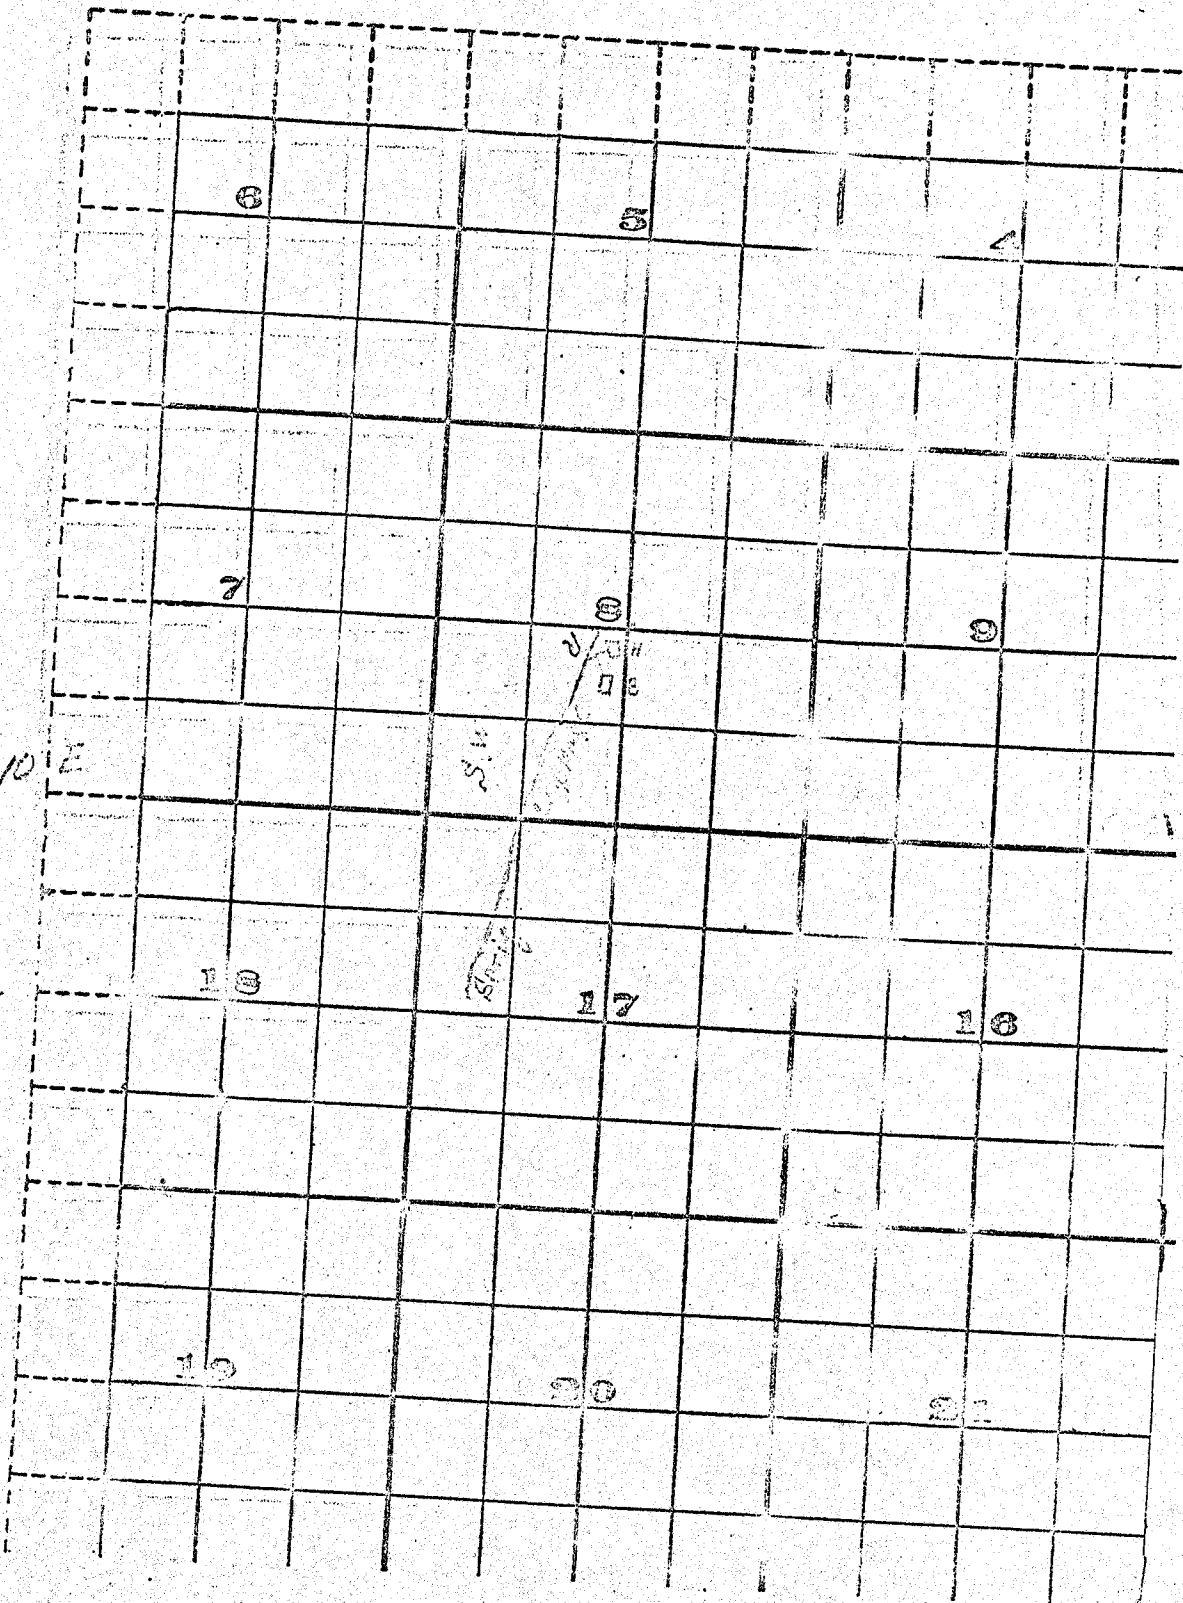

710

T7S R10E

App 4482

Per 2635