


15593

15806

1. Wm. J. Brayton of FLORENCE, ORE.
certify this map was made from notes
taken by me during an actual survey
on June 15-56.

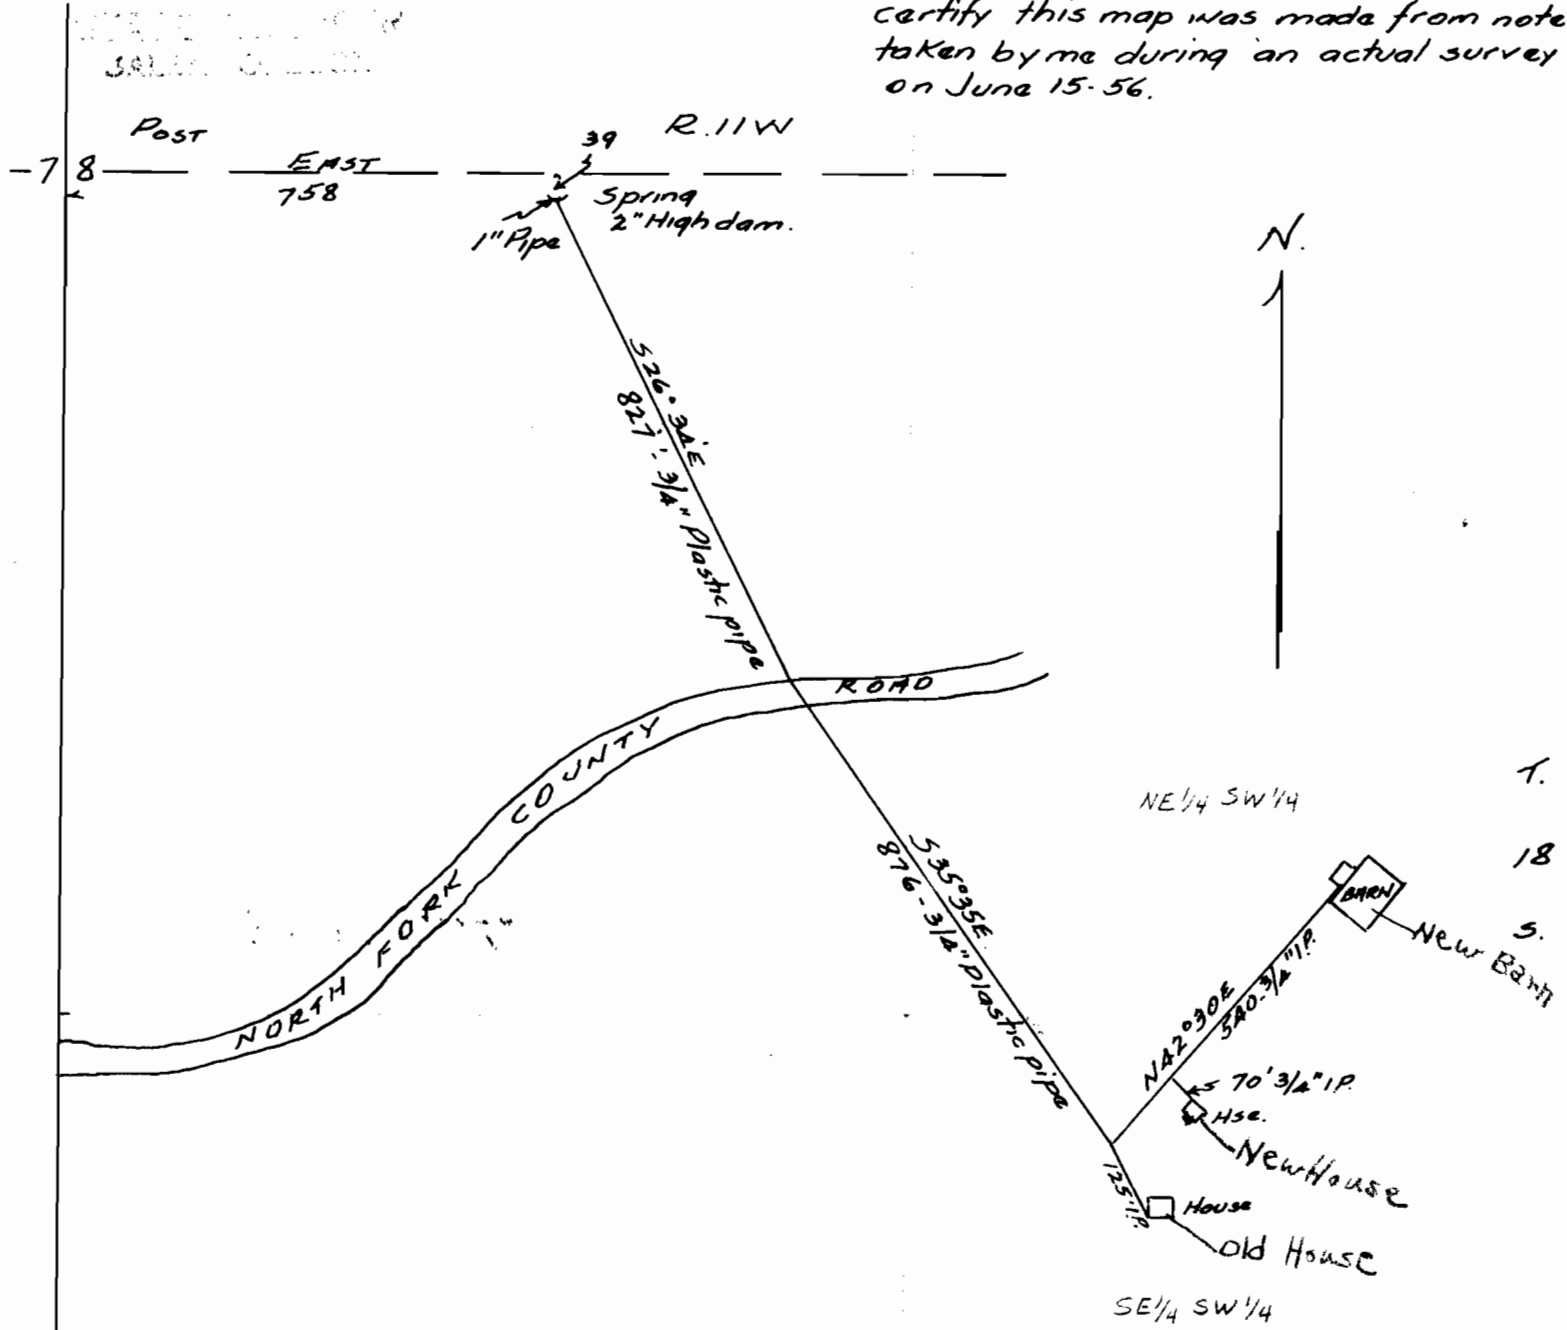

SURVEY
 ELSIE JOHNSON
 SEC. 8, T. 18 S., R. 11 W. W.M.
 LANE COUNTY
 Scale 1" = 300' June '56.

Application No. 31504
 Permit No. 24853

78
 1817