


R. 12 W

R 11 W

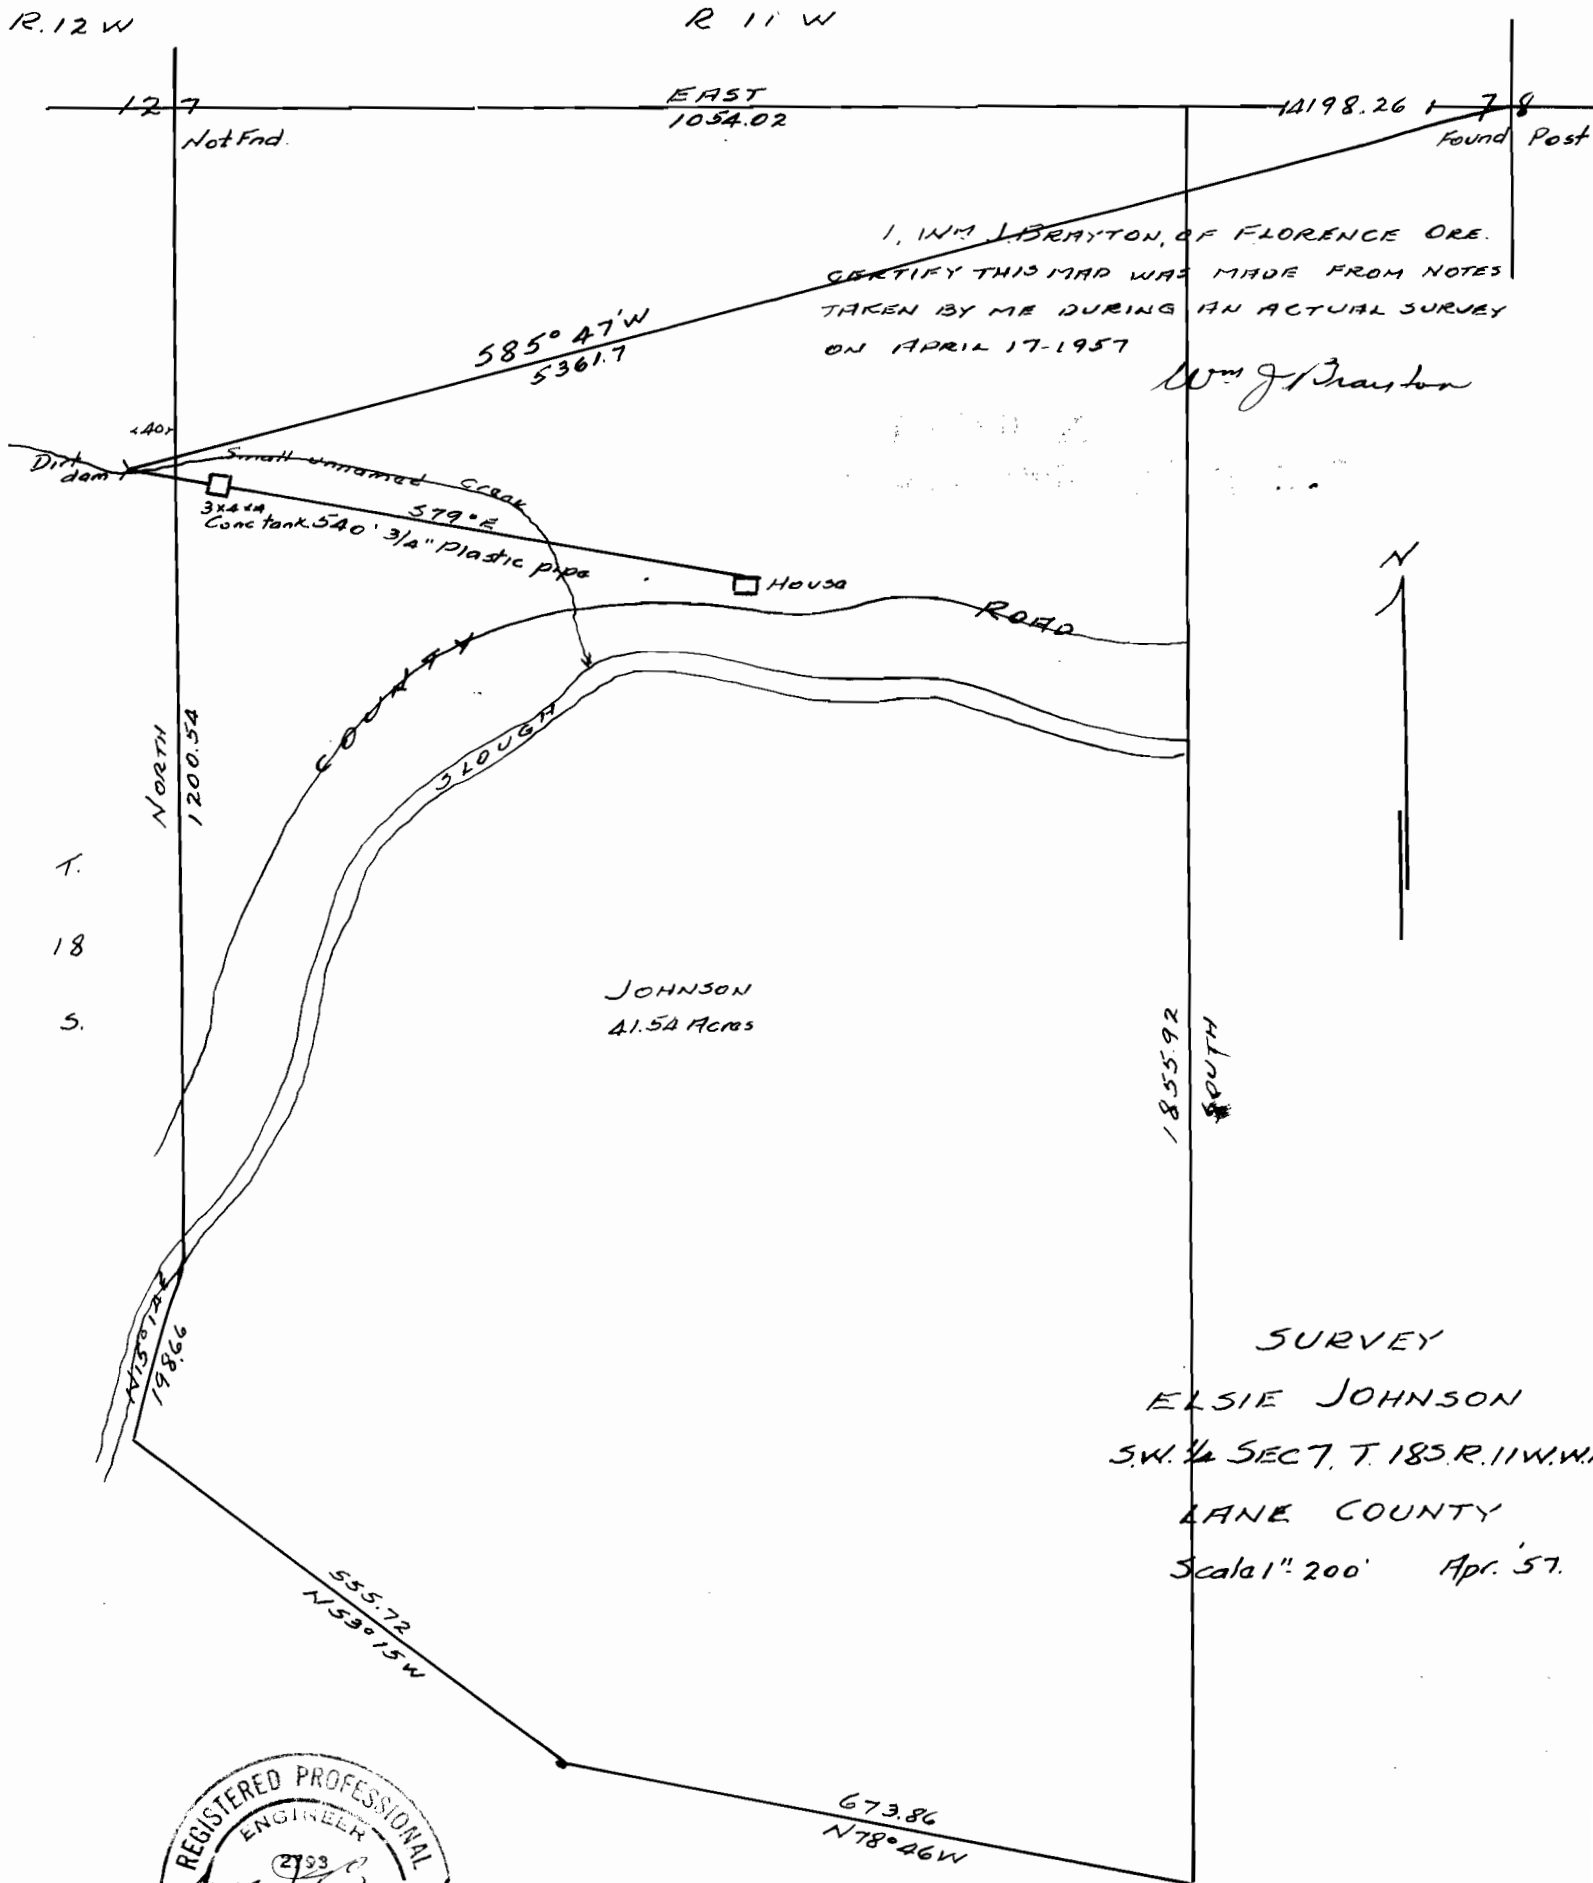

SURVEY

ELSIE JOHNSON

S.W. 1/4 SEC 7, T. 18 S. R. 11 W. W.

LANE COUNTY

Scale 1" = 200' Apr. '57.



Application No. 31503

Permit No. 24890