


RECEIVED
AUG 1 1962
STATE ENGINEER

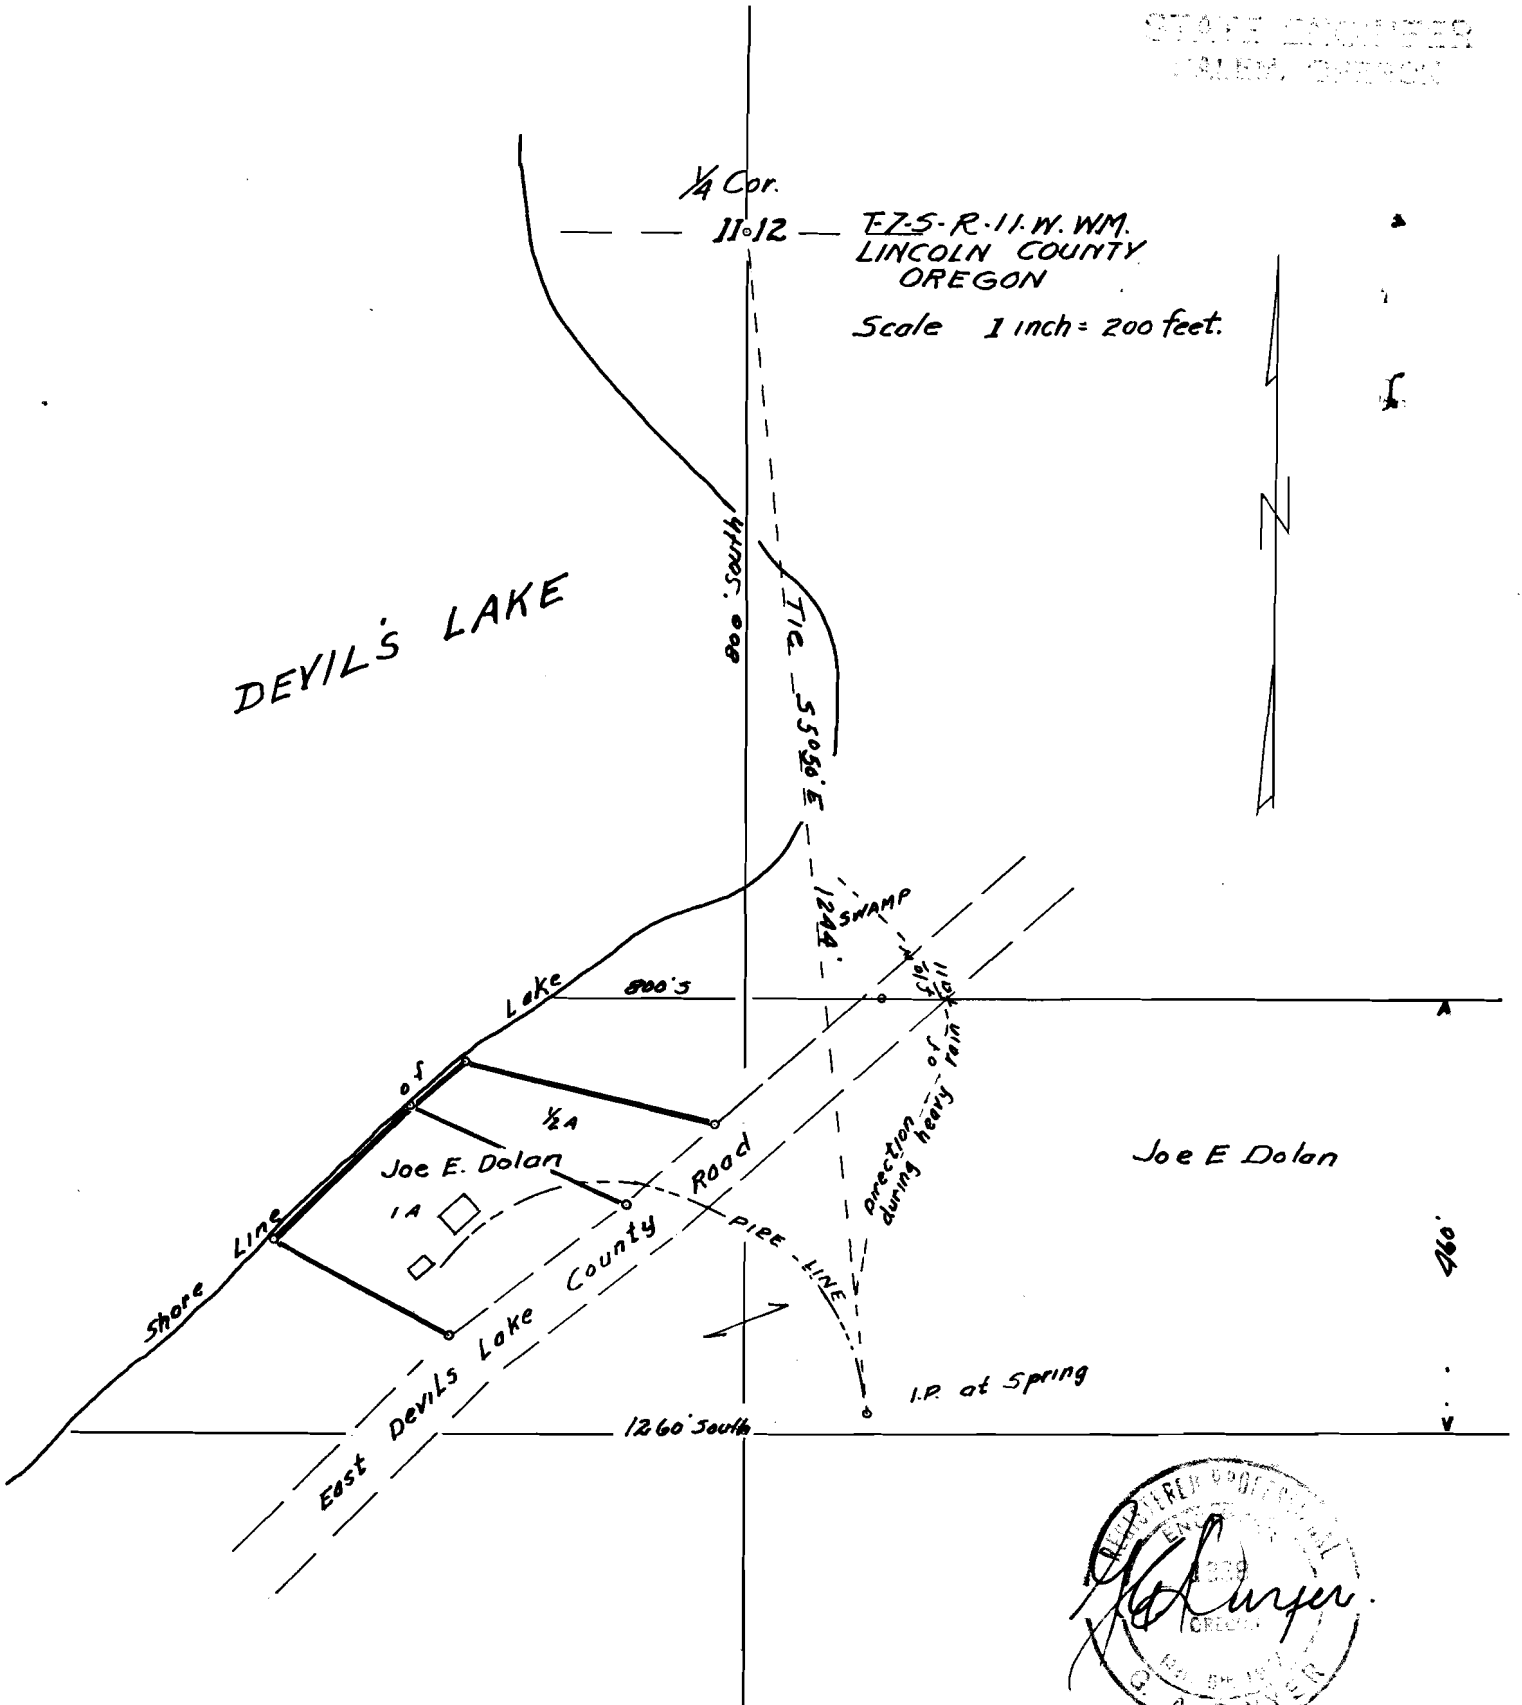

Application No. 27515
Permit No. 23651