


T. 6S. R. 2W. WM

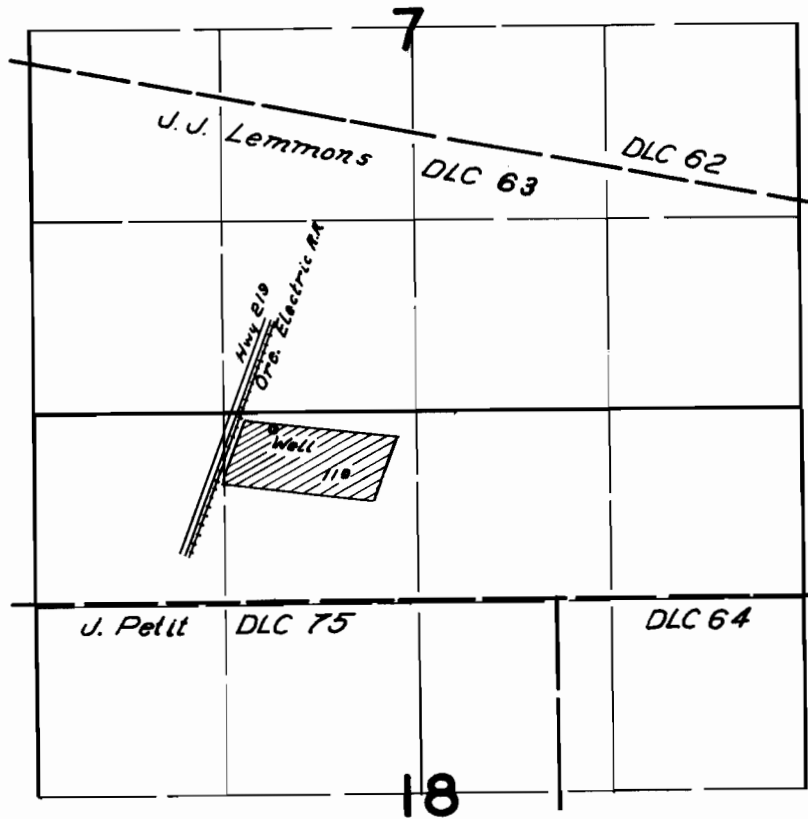

FINAL PROOF SURVEY UNDER

Application No. *G509* Permit No. *G426*
IN NAME OF

O.L. Parker

Surveyed *June 12 1958*, by *C.O. Bartels*