


T. 7 S. R. 2 W. W. M.

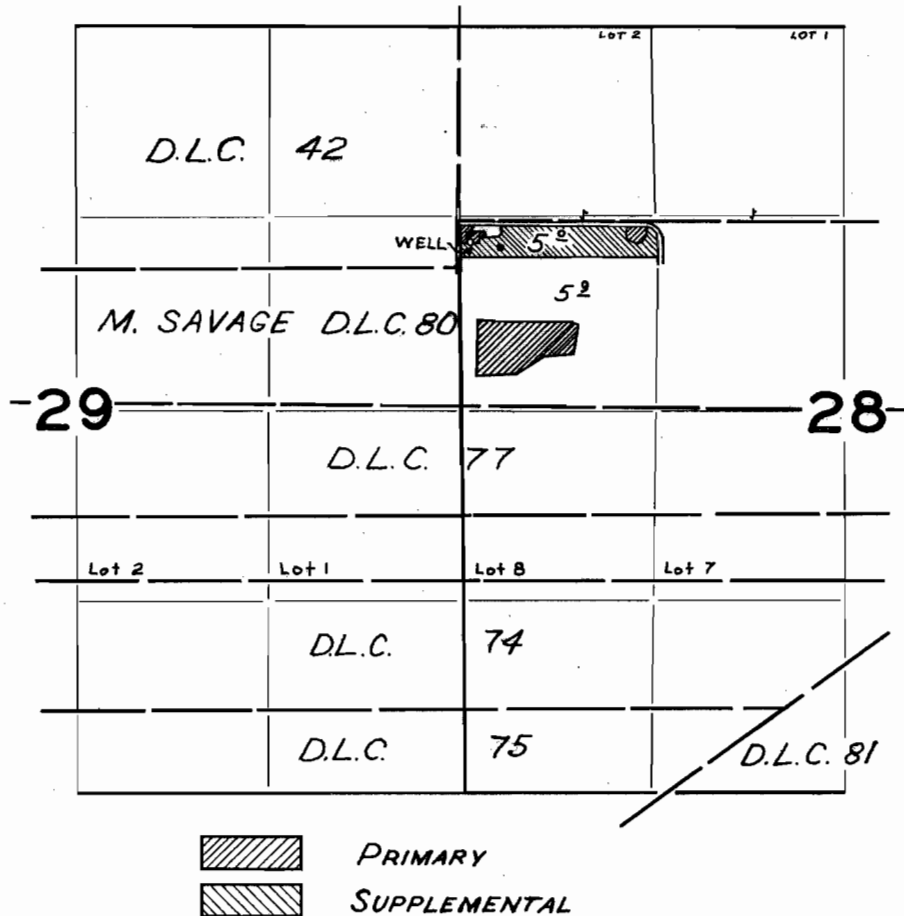

FINAL PROOF SURVEY
UNDER

Application No. G-2536 Permit No. G-2348
IN NAME OF

LEROY KUPER

Surveyed JUN 22 1964, by R. JACKSON