


T. I. S. R. 3 E. W. M.

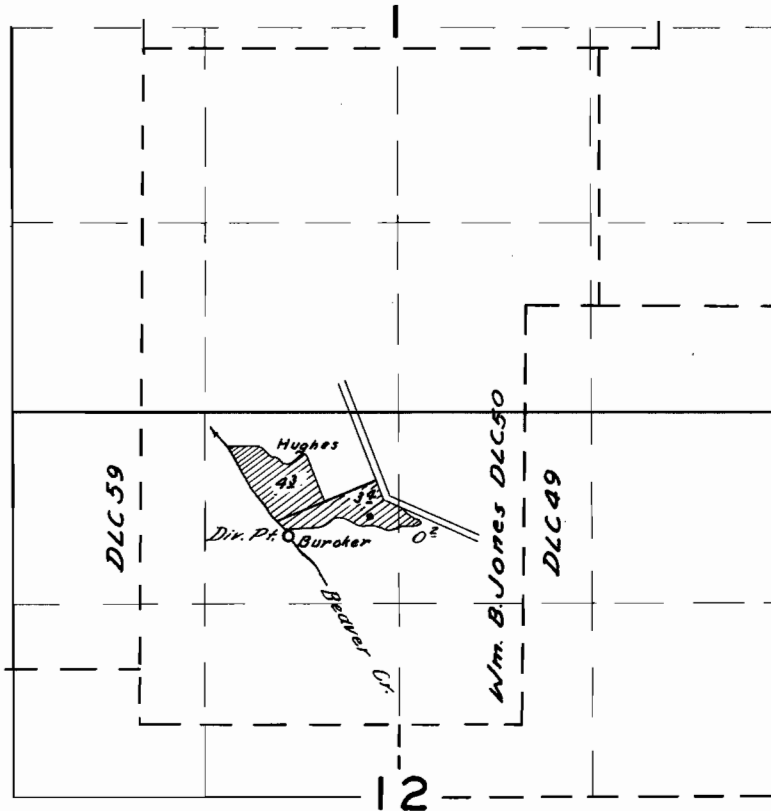

FINAL PROOF SURVEY

UNDER

Application No. ¹⁸²¹⁴~~18221~~..... Permit No. ¹³⁹⁹⁴~~19608~~.....

IN NAME OF

Stephen Hughes

L. F. & M. BURAKER

Surveyed *June 27, 1956*, by *R. H. Whitby*.

DFO-5D-22

C.B.