


T. 2S. R. 1W. W.M.

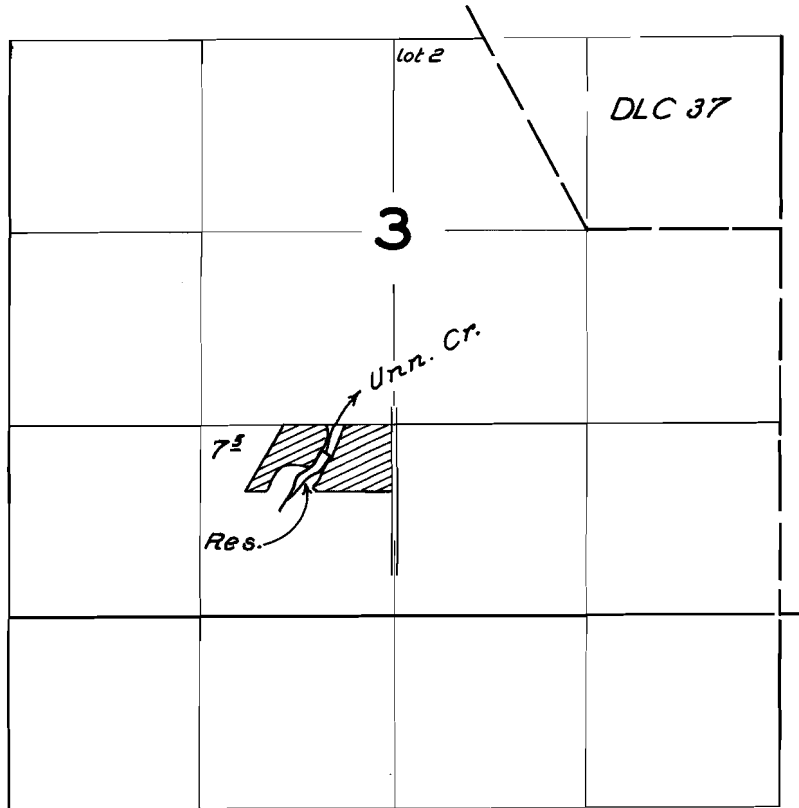

FINAL PROOF SURVEY
UNDER

Application No. R27444 27597 Permit No. R1397 21649
IN NAME OF

Jack Warnstaff

Surveyed Sept. 15 1959, by C.O. Bartels