


T. 14S. R. 8W. W.M.

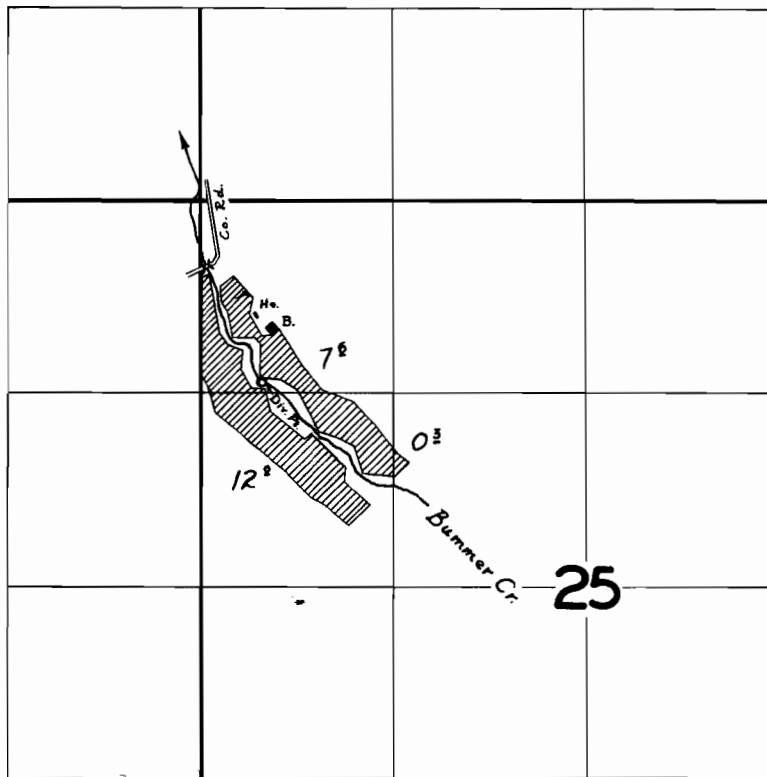

FINAL PROOF SURVEY

UNDER

Application No. 25752 Permit No. 20265

IN NAME OF

Eugene Bedell

Surveyed Apr. 6 1959, by M. Bish