


T. 10S. R. 3W. W.M.

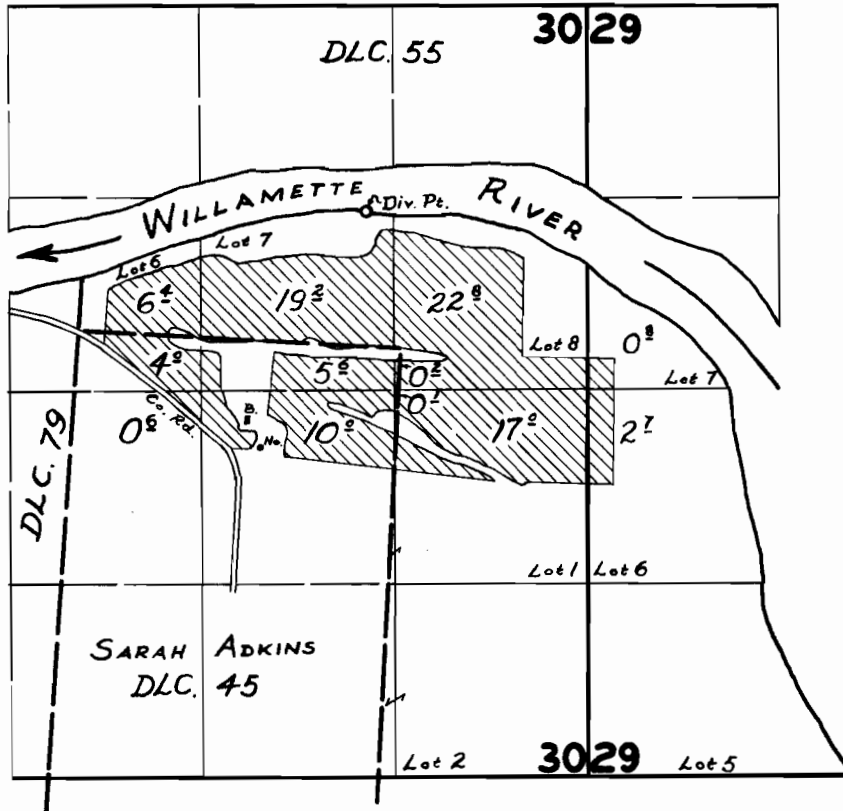

FINAL PROOF SURVEY

UNDER

Application No. 31984 Permit No. 25240

IN NAME OF

HARRY A. NELSON

Surveyed 16 SEPT 19 58, by M. BISH