


T. 4S. R. 1E. W.M.

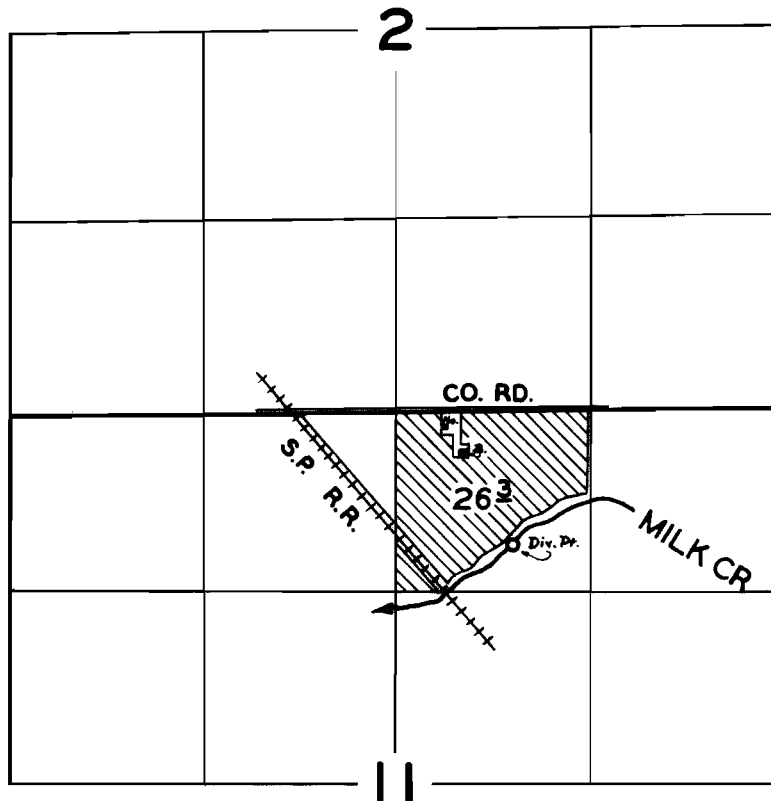

FINAL PROOF SURVEY
UNDER

Application No. 26144 Permit No. 20990
IN NAME OF

I.C. BERNEY

Surveyed 25 AUG. 1958, by M. BISH