


# T. 3S. R. 1E. W.M.

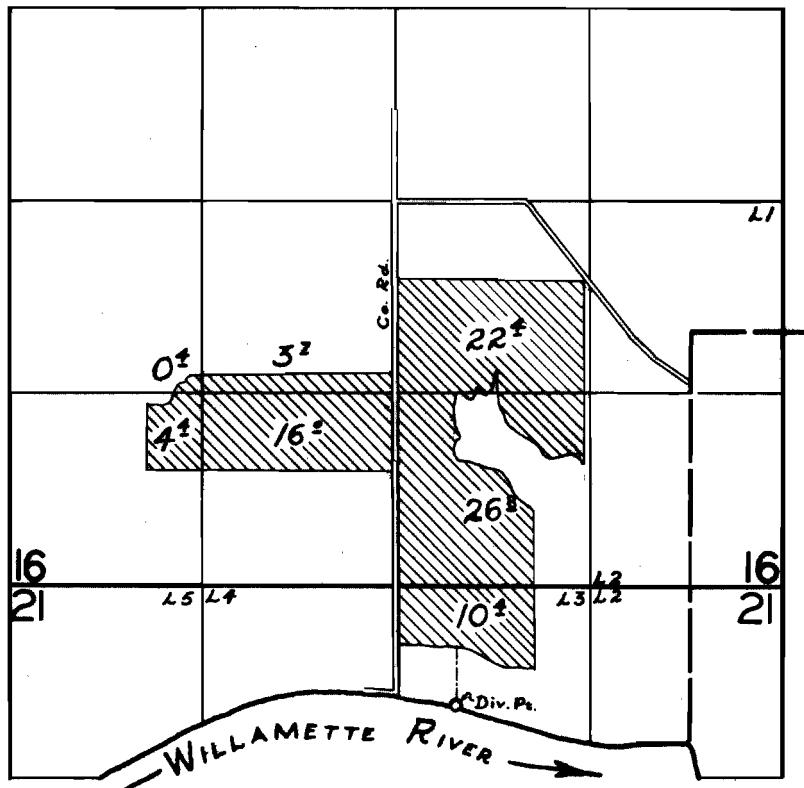

## FINAL PROOF SURVEY

UNDER

Application No. 27378 Permit No. 21553

IN NAME OF

GEORGE E. & MARY H. FELL

Surveyed SEPT. 3 1959, by R. H. JACKSON