


T. 5 S. R. 3 E.

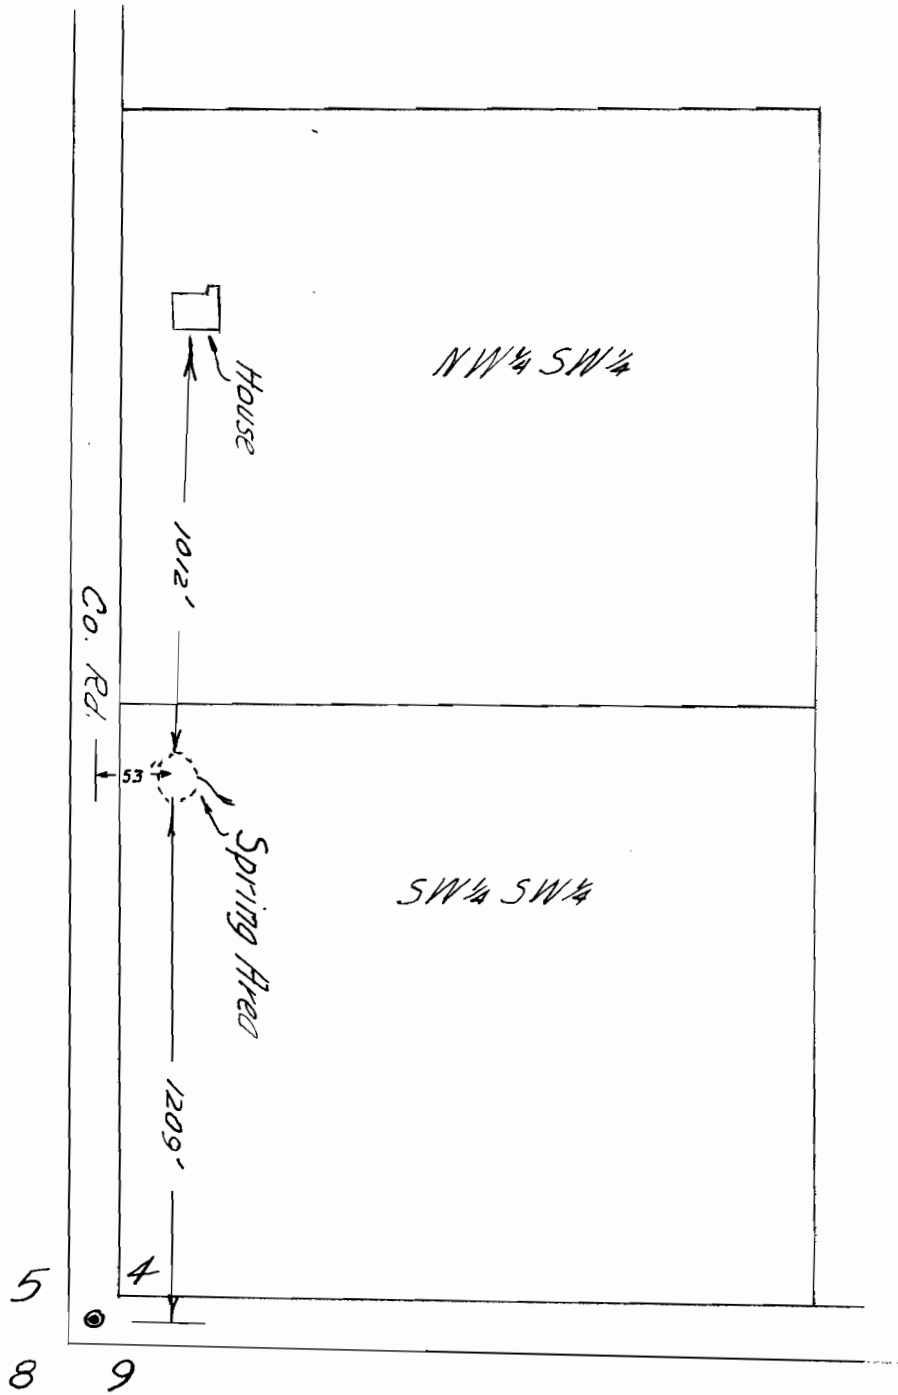

Scale: 1" = 400'

Application No. 27884
Permit No. 23664