


T. 2S. R. 1E. W.M.

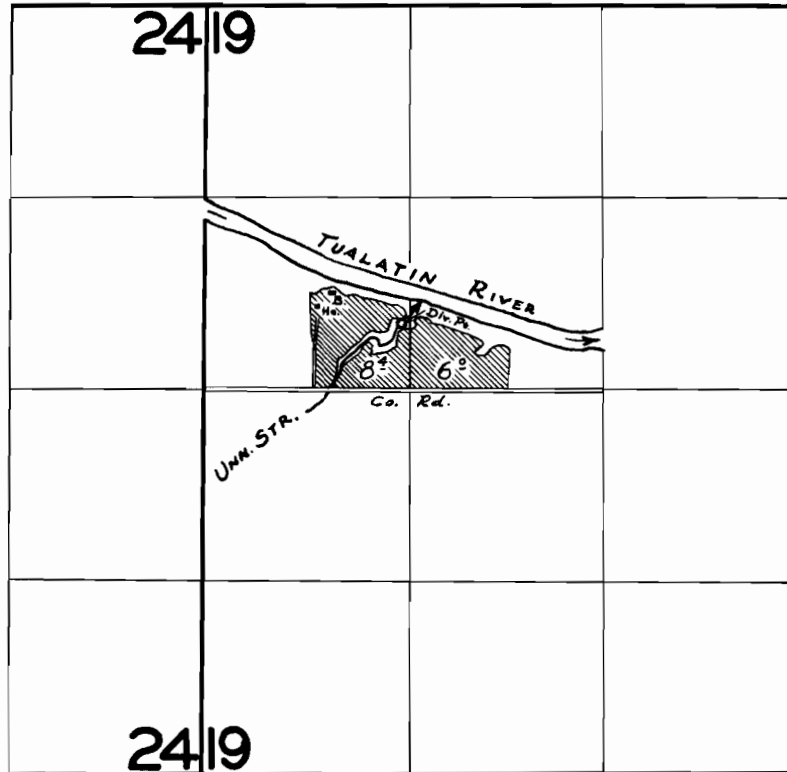

FINAL PROOF SURVEY

UNDER

Application No. 30568 Permit No. 24082

IN NAME OF

LEONARD A. HELGESSON

Surveyed SEPT. 10 19 59, by R. H. JACKSON