T. 3S. R. 2E. W.M.

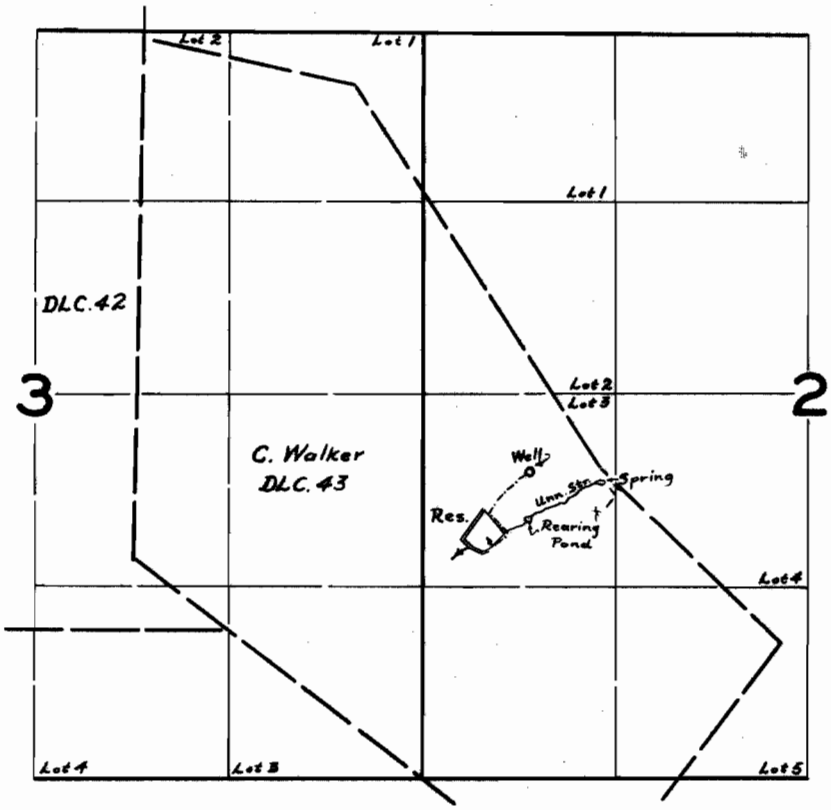

FINAL PROOF SURVEY

UNDER

Application No. R-31814 31815 Permit No. R-2068 25094

IN NAME OF

Floyd E. Fowler

Surveyed July 9 1959, by R. H. Jackson

1959 O