


T. 4N. R. 4W. W.M.

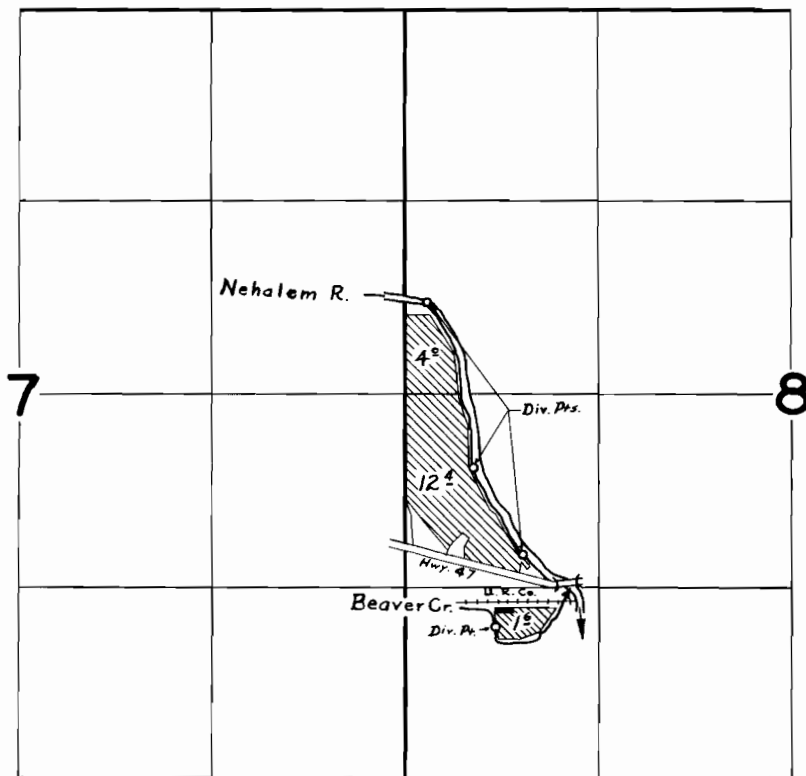

**FINAL PROOF SURVEY**  
UNDER

Application No. 28300 Permit No. 22250  
IN NAME OF

**E. P. CRAWFORD**

Surveyed JULY 8 1959, by M. BISH