


T. 6N. R. 3W.W.M.

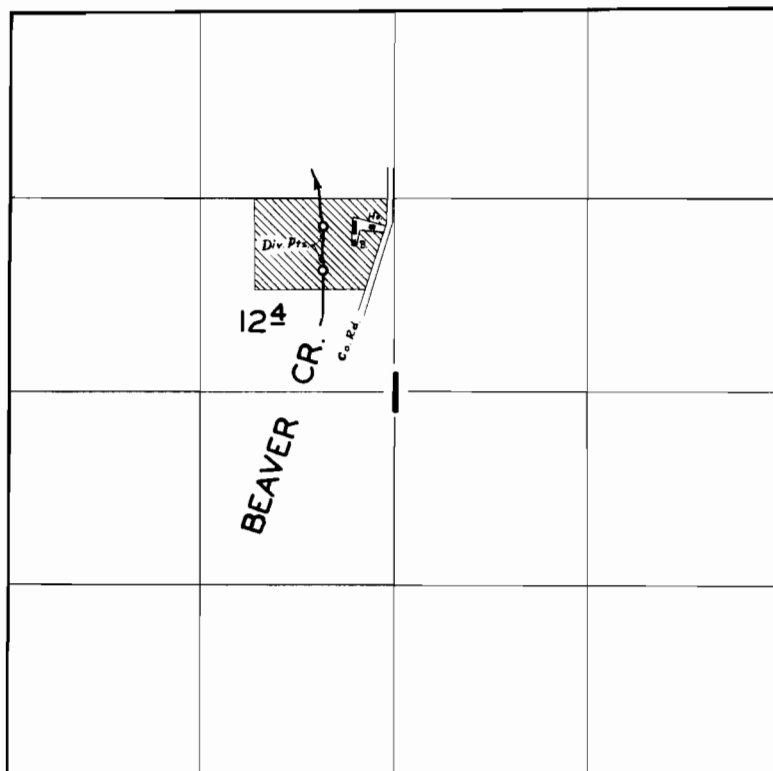

FINAL PROOF SURVEY
UNDER

Application No. 28732 Permit No. 22611
IN NAME OF

JAMES W. & GERTRUDE A. HOARD

Surveyed JULY 9 1959 by M. BISH