


T.23S.R.7 W.W.M.

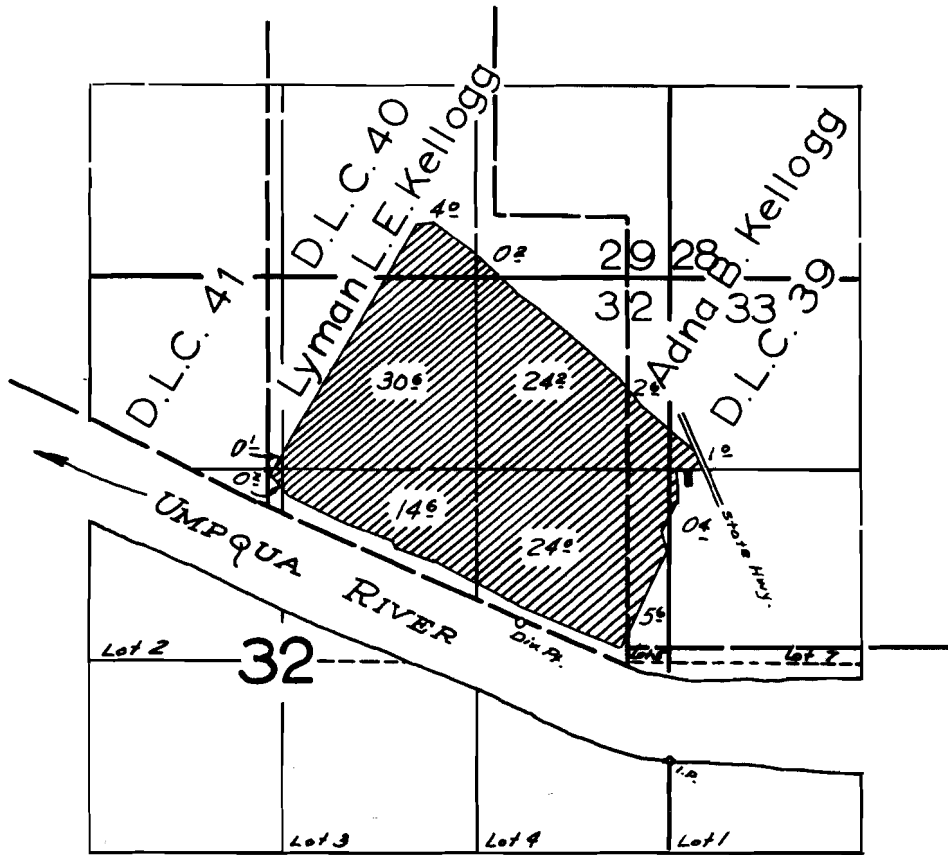

FINAL PROOF SURVEY
UNDER

Application No. 20633. Permit No. 16138.
IN NAME OF

George K. Ching

Surveyed June 26, 1959, by *R. Jackson*