


T. 28S. R. 6W. W.M.

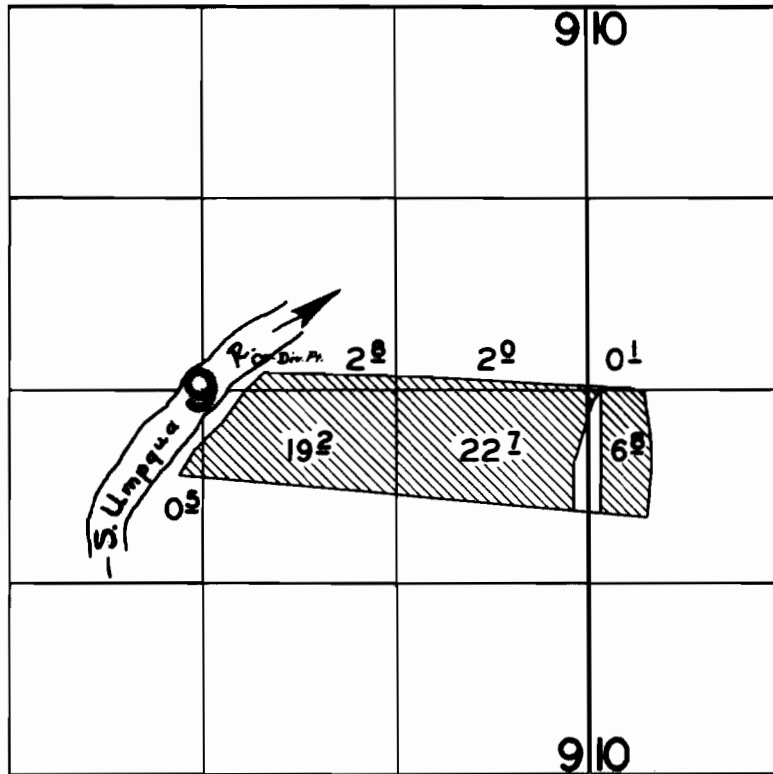

FINAL PROOF SURVEY
UNDER

Application No. 26829 Permit No. 20951
IN NAME OF

FRANK B. COOPER

Surveyed JUN. 24 1959, by M. BISH