


T. 25 S. R. 6 W. W. M.

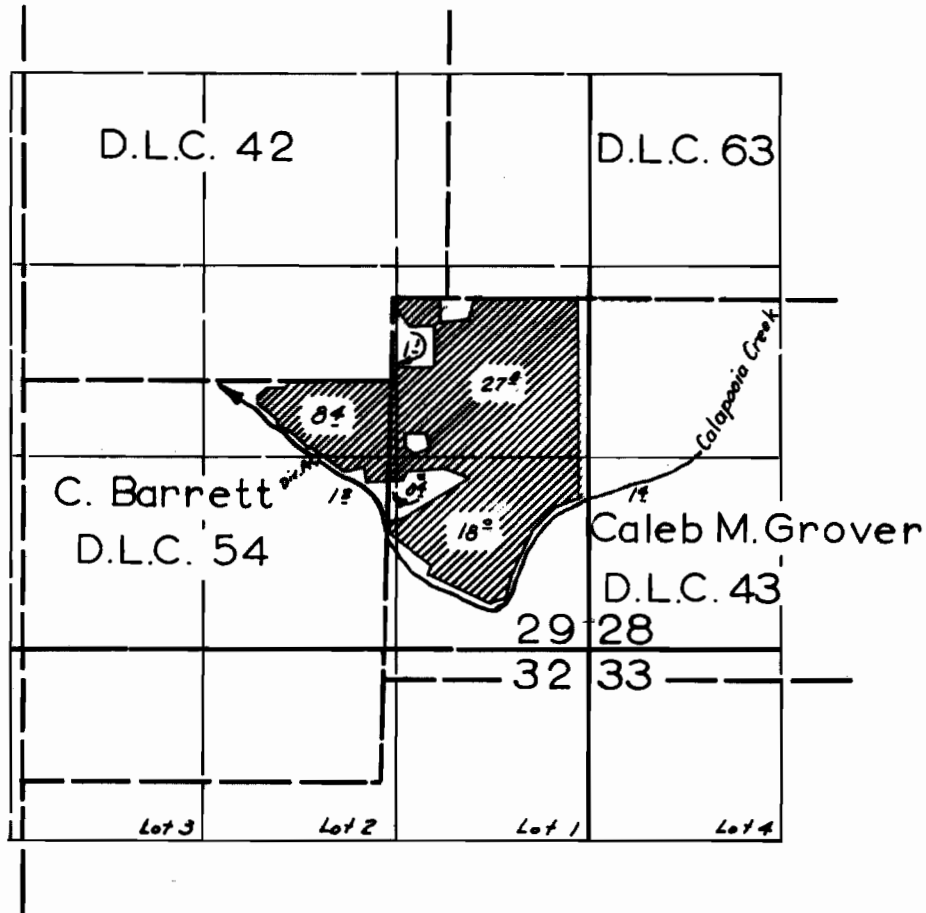

FINAL PROOF SURVEY
UNDER

Application No. 26824 Permit No. 21066
IN NAME OF

GAIL WINNIFORD

Surveyed June 22 1959, by R. Jackson