


T. 2S. R. 1&2E. W.M.

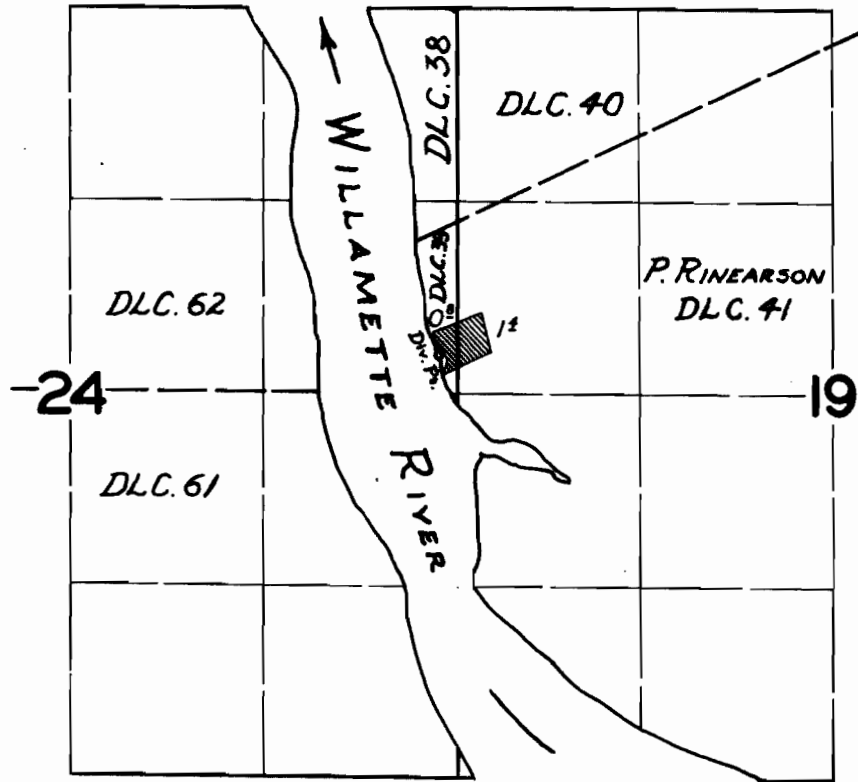

FINAL PROOF SURVEY

UNDER

Application No. 29671 Permit No. 23365

IN NAME OF

DR. PAUL E. DUTTON

Surveyed SEPT. 10 1959, by R. H. JACKSON