


T. 29S. R. 4W. W.M.

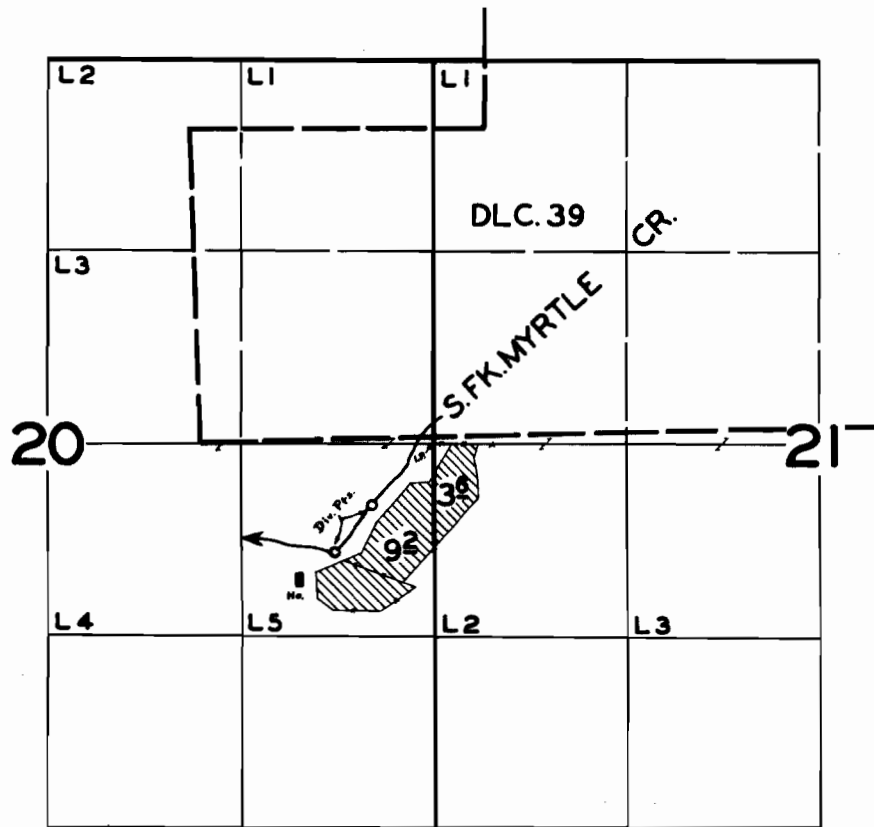

FINAL PROOF SURVEY
UNDER

Application No. 28751 Permit No. 23922
IN NAME OF

ILO & MARGARET DYER

Surveyed JUN. 23 1959, by M. BISH